

UNITED STATES PUBLIC LAND SURVEY CORNER CERTIFICATE

OF

Recorded


Land Survey Monuments situated in Section 7, Township 87N, Range 12W, of the Fifth Principal Meridian, BLACK HAWK County, Iowa.
Previously recorded in N/A in County Recorder's Office.
(book, page, document number, etc.)

Reason for preparing this certificate, the evidence and detailed procedures used in establishing the corner positions and monumentation found or placed.)

Monument Description and Remarks: FOUND 5/8" & REBAR 1" DEEP IN ASPHALT PAVING
PER COUNTY TIES.

PLAN - VIEW


(Show a minimum of three reference ties to durable physical objects, relevant monuments and physical conditions that will enable recovery of the corner.)

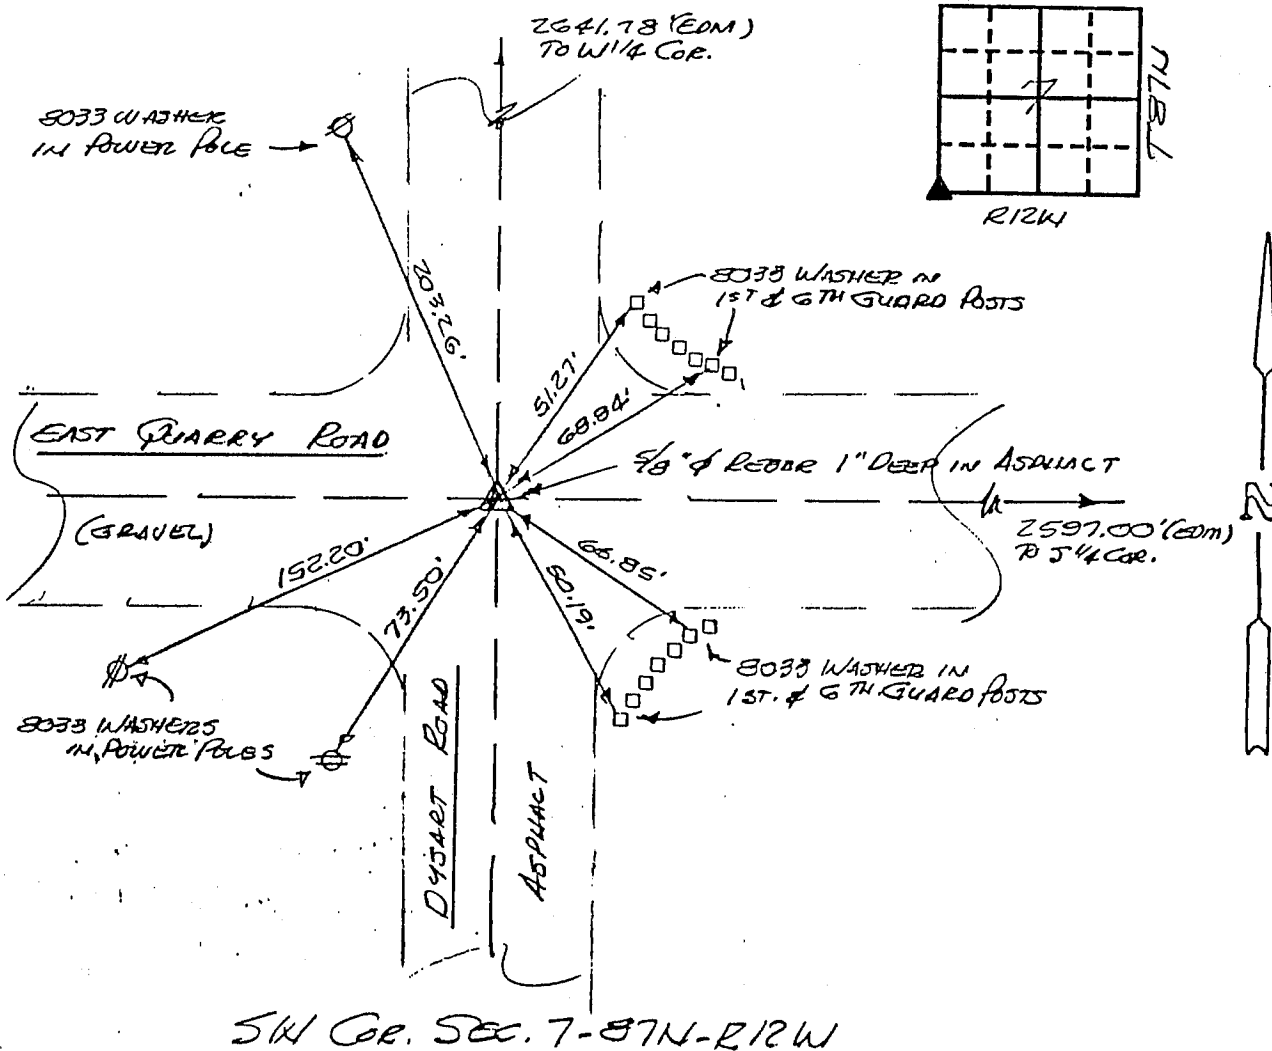

SW Cor. Sec. 7-87N-R12W

I hereby certify that the survey work was completed and this certificate was prepared by me or under my direct personal supervision and that I am a duly registered land surveyor under the laws of the state of Iowa.

Signature: F. William King
Name typed or printed: F. WILLIAM KING
Date: 12-17-1990 Reg. No. 8033

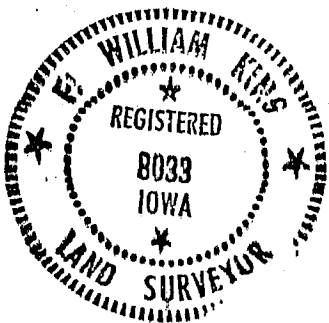

Corners	Section	Twp	Range
SW	7	87N	12W
NE	13	87N	13 W