

X Jeffrey P. Helland, 1107 Technology Parkway, Cedar Falls, Iowa 50613-6951, (319)-266-0161

UNITED STATES PUBLIC LAND SURVEY CORNER CERTIFICATE OF

LAND SURVEY MONUMENTS SITUATED IN SECTION NO. 9, TOWNSHIP NO. 87 NORTH, RANGE
NO. 12 WEST OF THE FIFTH PRINCIPAL MERIDIAN, BLACK HAWK COUNTY, IOWA.
PREVIOUSLY RECORDED IN FEE BOOK #2006 28361

(SHOW REASON FOR PREPARING THIS CERTIFICATE, THE EVIDENCE AND DETAILED PROCEDURES USED IN ESTABLISHING THE
CORNER POSITIONS AND MONUMENTATION FOUND OR PLACED.)

MONUMENT DESCRIPTION AND REMARKS:

USPLSCC FEE BOOK #2006 28361 REFERENCE TIES HAVE CHANGED. SURVEY COMPLETED IN THE SE 1/4 OF
SEC. 4-T87N-R12W AND THE SW 1/4 OF SEC. 3-T87N-R12W.

→ N 1/4 CORNER: USPLSCC FEE BOOK #2006 28361 DATED 5/25/2006 CALLS FOR [FOUND CONCRETE MONUMENT 6" DEEP].
ALL REFERENCE TIES AND FENCES HAVE BEEN OBLITERATED. FOUND STANDARD 4" CONCRETE MONUMENT w/BRASS CAP
0.4'± DEEP, SELY OF T-POST. NO GERMANE, DURABLE OBJECTS TO REFERENCE.



PLAN VIEW

(SHOW A MINIMUM OF THREE REFERENCE TIES TO DURABLE PHYSICAL OBJECTS, RELEVANT MONUMENTS AND PHYSICAL
CONDITIONS THAT WILL ENABLE RECOVERY OF THE CORNER.)

LEGEND

(0.0')S PER PLAT OF SURVEY DATED 3/22/1989
IN 284 MISC. 700

(0.0')C PER PLAT OF SURVEY DATED 5/23/2006
IN FEE BK #2006 28362

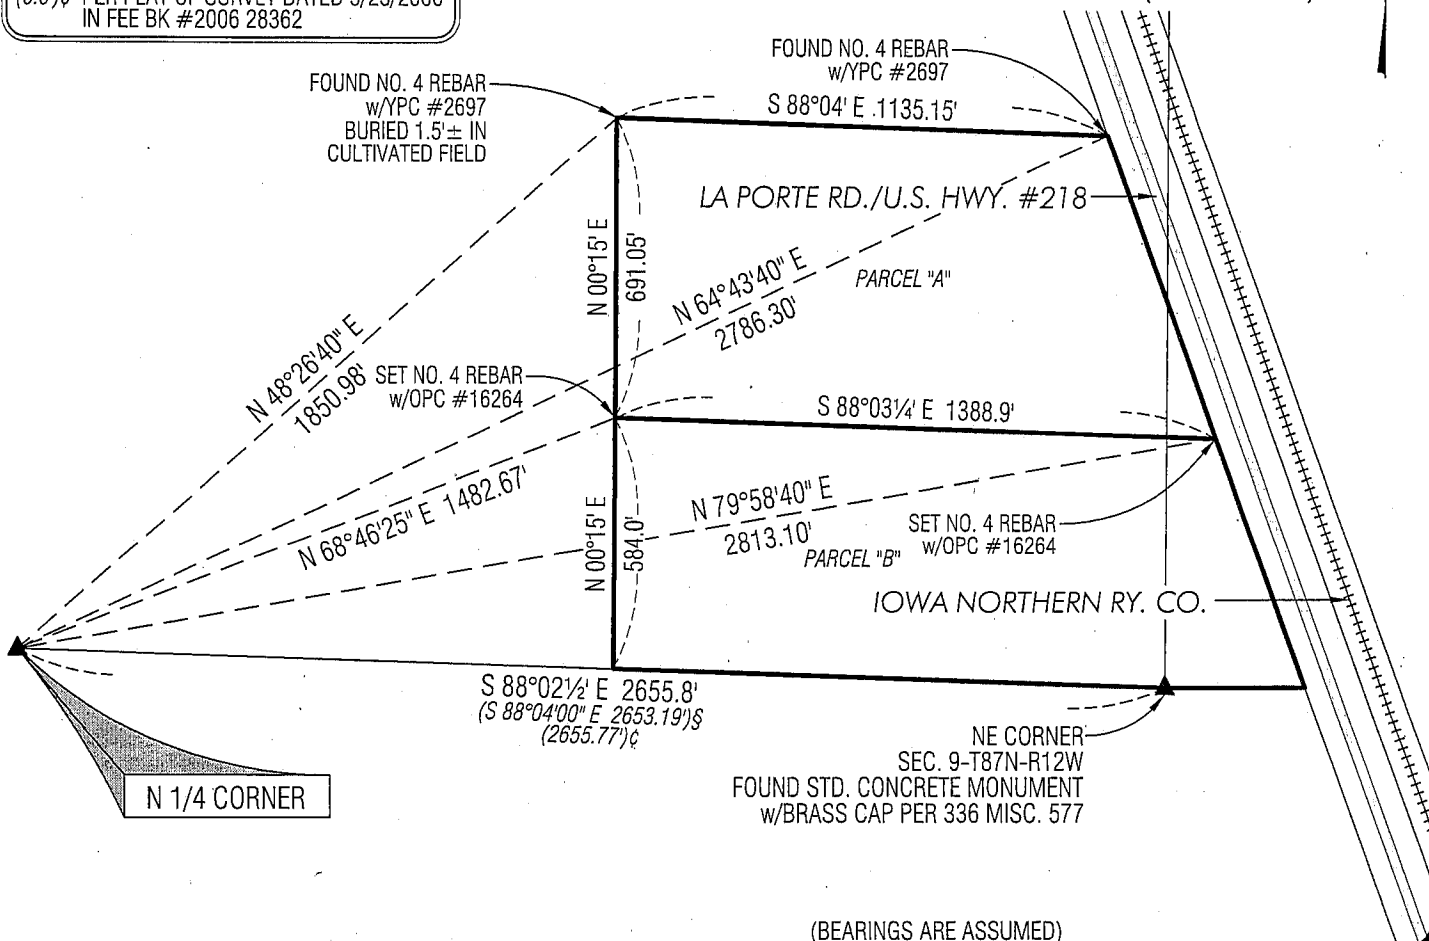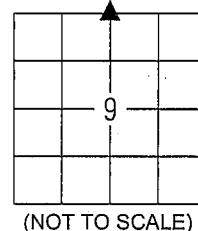


(BEARINGS ARE ASSUMED)



HELLAND ENGINEERING & SURVEYING, LTD.
1107 Technology Parkway
Cedar Falls, Iowa 50613-6951
(319)-266-0161

SHINER = 8D NAIL & 1 5/16" Ø METAL SHINER
BRASS TAG = 8D NAIL & 13/16" Ø BRASS TAG
OPC = PLASTIC CAP (O=ORANGE, R=RED, Y=YELLOW)
(00') RECORDED AS FILE NAME: 09-244C1.DWG

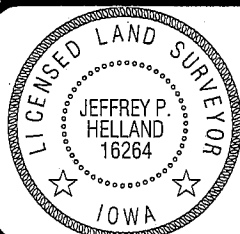

I hereby certify that this land surveying document was prepared
and the related survey work was performed by me or under my
direct personal supervision and that I am a duly licensed Land
Surveyor under the laws of the State of Iowa.

Jeffrey P. Helland 10/23/09
Jeffrey P. Helland
License Number 16264
My license renewal date is December 31, 2009.
All pages or sheets are covered by this seal except:

LIST CORNERS TO BE INDEXED

CORNER	SECTION	TOWNSHIP	RANGE
N 1/4 CORNER	9	87N	12W
S 1/4 CORNER	4	87N	12W

Rec