

X Env

Herold - Reicks Surveying, 25 1/2 East Main Street, Suite 204, New Hampton, IA 50659, Ph. 641-394-2725

UNITED STATES PUBLIC LAND SURVEY CORNER CERTIFICATE

Land Survey Monuments situated in Section **11**, Township **87** North, Range **12** West of the Fifth Principal Meridian, **Black Hawk** County, Iowa. Previously not recorded in the County Recorder's office.

This certificate is being prepared in compliance with Iowa Code Chapter 355.11 because:

- ☒ There are no certificates on file for these corners.
☐ There are no longer three valid ties of record.
☐ There are changes to reference ties of record.
☐ There is change of monumentation of record.
☐ To clarify description of record monument (ties).


Monument Description and Remarks:

1.) Southeast Corner of the SW 1/4-SW 1/4: Set 5/8"Ø rebar w/ 2"Ø aluminum cap PLS 15525 equidistant and online between the Southwest and the S 1/4 Corners of the Section.

2.) South 1/4 Corner: Fd. Conc. Monu. w/Brass Cap, Black Hawk County, corner located from information obtained from the County Engineer's Office.

PLAN - VIEW

(Show a minimum of three reference ties to durable physical objects, relevant monuments and physical conditions that will enable recovery of the corner.)

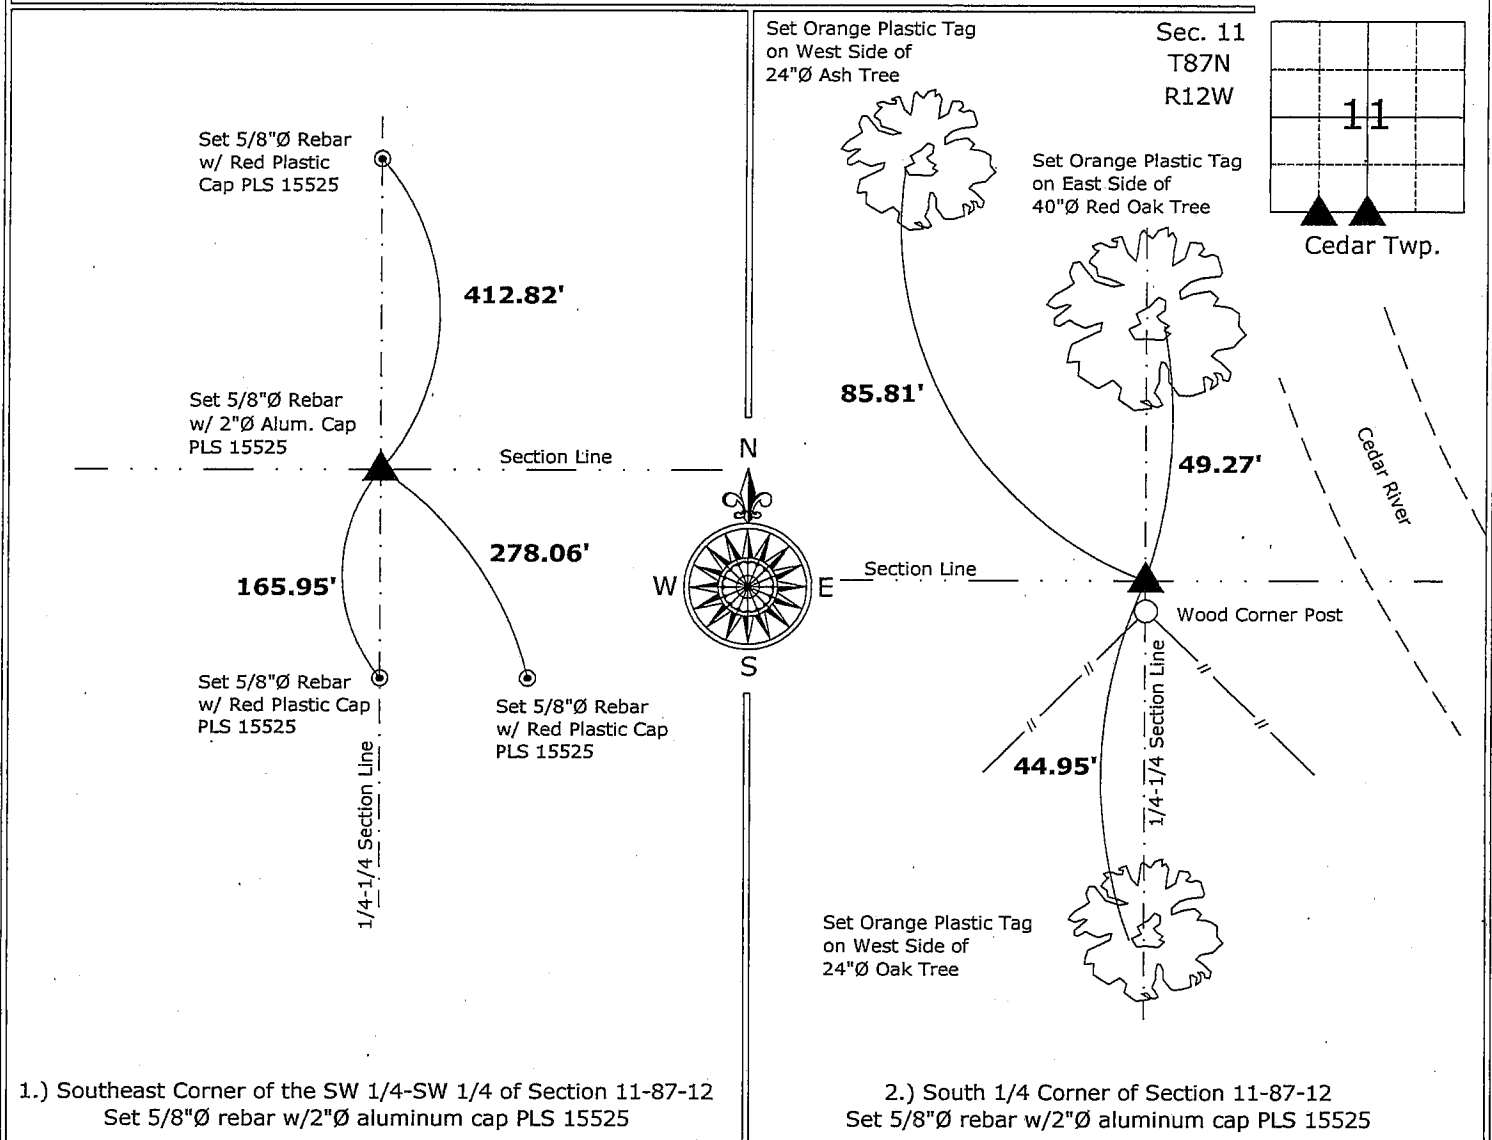

1.) Southeast Corner of the SW 1/4-SW 1/4 of Section 11-87-12
Set 5/8"Ø rebar w/2"Ø aluminum cap PLS 15525

2.) South 1/4 Corner of Section 11-87-12
Set 5/8"Ø rebar w/2"Ø aluminum cap PLS 15525



I hereby certify that this land surveying document was prepared and the related survey work was performed by me or under my direct personal supervision and that I am a duly licensed Land Surveyor under the laws of the State of Iowa.

Paul R. Herold 9-5-09
Paul R. Herold Date:

License number 15525
My license renewal date is December 31, 2010.
Sheets covered by this seal: Individual sheet only

List Corners to be Indexed			
Corners	Section	Twp.	Range
SE SW SW	11	87	12
S 1/4	11	87	12

Project Number:2009-098

FB: Black Hawk County 1, Pgs. 8-9