

PROOF **FILED FOR RECORD JUL 7, 2003, AT 3:00P. M. FEE N/C**COMPARED **BLACK HAWK COUNTY RECORDER**

BLACK HAWK COUNTY ENGINEER

PREPARED BY: **BLACK HAWK COUNTY ENGINEERS OFFICE**
316 E. FIFTH STREET, ROOM 211 WATERLOO, IOWA 50703PH.# (319) 833-3008
FAX.# (319) 833-3139SLSI 9-94
CERT 12-96

UNITED STATES PUBLIC LAND SURVEY CORNER CERTIFICATE OF
Land Survey Monuments situated in Section 12, Township 87 N,
Range 12 W, of the Fifth Principal Meridian, BLACK HAWK County, Iowa.
Previously recorded in Misc. Book N/A, Page N/A, in County Recorder's Office.

(Show reason for preparing this certificate, the evidence and detailed procedures used in establishing the corner positions and monumentation found or placed.)

Monument Description and Remarks: E. 1/16 CORNER SECTION 12-87-12.
EST. 5/8" REBAR W/ 2" ALUM. CAP STAMPED "BLACK HAWK COUNTY LAND
CORNER", vs. REFERENCED 1/2" REBAR PER PLAT OF SURVEY, MISC. 301-932.
PER RECORD N.E. CORNER & N. 1/4 COR. PLS #8033, FND. 1/2" REBAR WAS "NOT"
REF.ED TO LAND LINE RECORDS, NOR LAND DEED RECORDS FOR R/W. CORNER
EST. IN ACCORD. WITH N. LINE OF NE1/4, REC. ROW, & N. BARBER (1910 PLAT).

PLAN - VIEW


(Show a minimum of three reference ties to durable physical objects, relevant monuments and physical conditions that will enable recovery of the corner.)

NOTE: ALL DISTANCES PLUMB


"S.M." = DENOTES "PLASTIC SURVEY MARKER" Tag

"P" = DENOTES Platted Dim. by PLS #6505
per Misc. Bk. 301 p. 932"R" = DENOTES Record Meas. by Nathan
Barber, Co. Surveyor Dec. 1910

"WPA" = DENOTES Meas. to 1/4-1/4 Fence N&S.

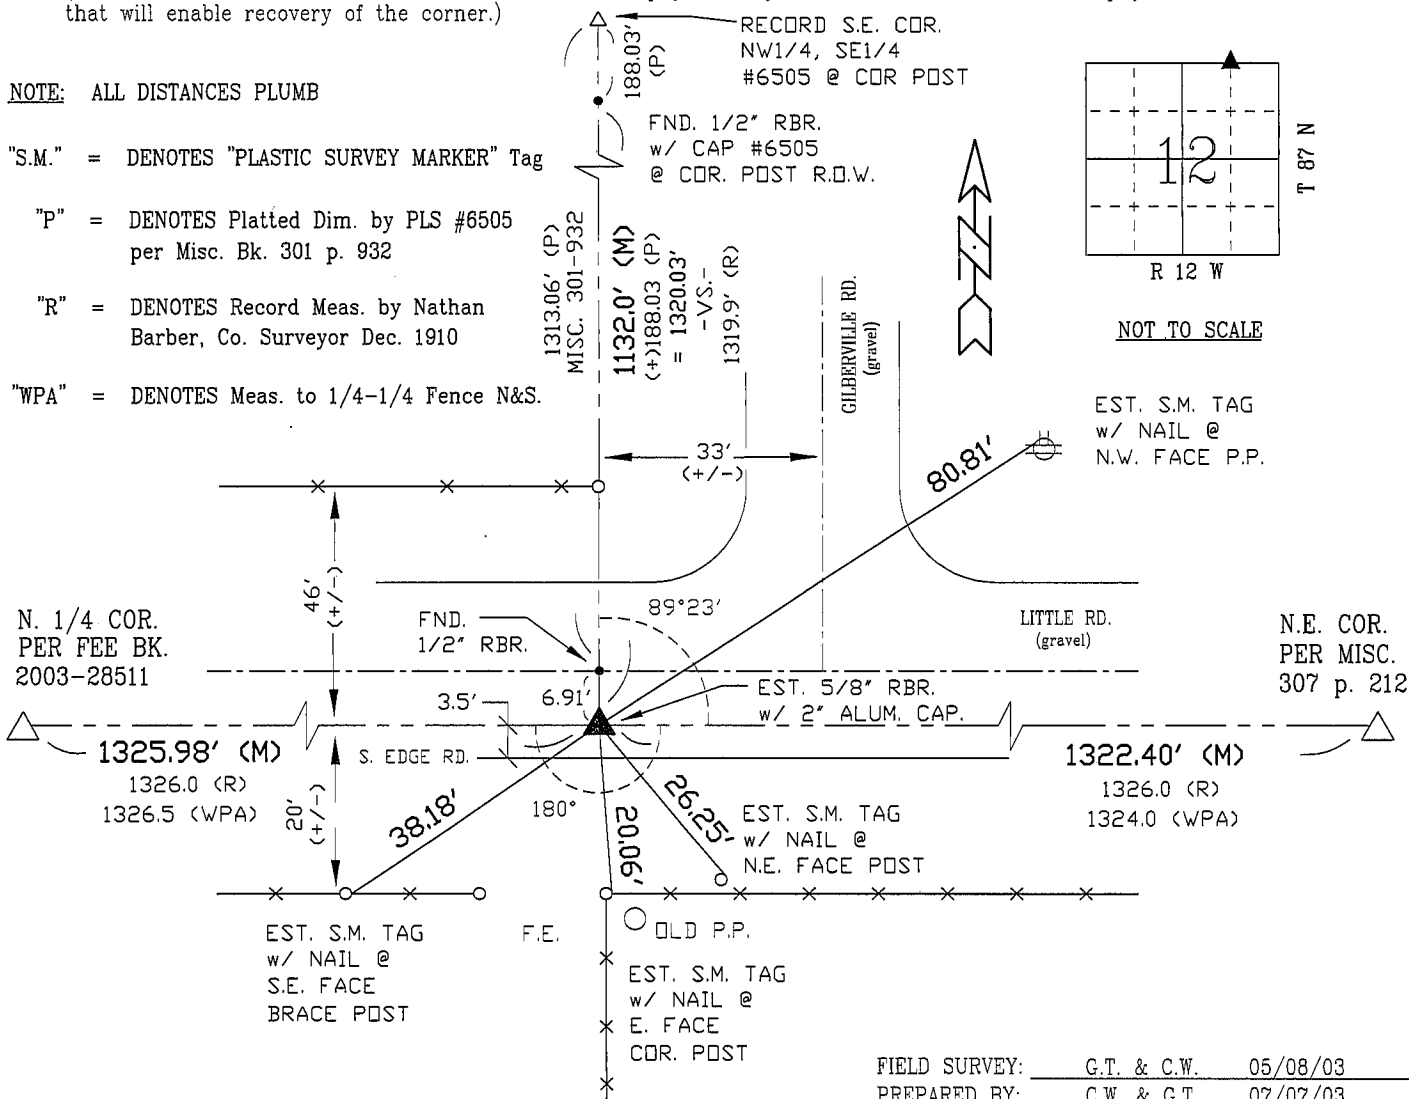FIELD SURVEY: G.T. & C.W. 05/08/03
PREPARED BY: C.W. & G.T. 07/07/03

CERTIFICATION

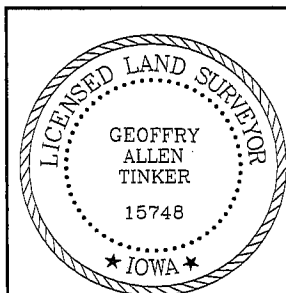

I hereby certify that this land surveying document was prepared and the related survey work was performed by me or under my direct personal supervision and that I am a duly licensed Land Surveyor under the laws of the State of Iowa.

Geoffrey Allen Tinker 07/07/03
(signature) (date)

License Number 15748My license renewal date is December 31, 2004

Pages or sheets covered by this seal:

This Land Corner Certificate Only.

LIST CORNERS TO BE INDEXED

Corner Section - Township - Range

N.E. COR. 12 87 N 12 W
NW1/4, NE1/4S.E. COR. 01 87 N 12 W
SW1/4, SE1/4