

ENV  
Herold - Reicks Surveying, 25 1/2 East Main Street, Suite 204, New Hampton, IA 50659, Ph. 641-394-2725

UNITED STATES PUBLIC LAND SURVEY CORNER CERTIFICATE

Land Survey Monuments situated in Section **14**, Township **87** North, Range **12** West of the Fifth Principal Meridian, **Black Hawk** County, Iowa. 1.) Previously recorded in Bk. 335, Pg. 185 in the County Recorder's office. 2.) Previously not recorded in the County Recorders Office.

This certificate is being prepared in compliance with Iowa Code Chapter 355.11 because:


2. ☒ There is no certificate on file for this corner.  
☐ There are no longer three valid ties of record.  
1. ☒ There are changes to reference ties of record.  
☐ There is change of monumentation of record.  
☐ To clarify description of record monument (ties).

Monument Description and Remarks:

- 1.) **West 1/4 Corner:** Fd. Conc. Monument, top 2" broken off, placed a Cut "X" in top for corner position, 2 of the previous ties were to building corners, that building has been removed, the foundation still remains, established 3 new ties to update the Corner.
- 2.) **South 1/4 Corner:** Found 3/4"Ø Gas Pipe 10" deep, Corner located from information provided by a local land owner who stated the Conc. Monu. was removed by an individual that built a driveway, he stated that the County re-established the corner at the correct location, the fence that lead to this corner as shown in the County Ties has been removed and a chamfer was added to the North Fence.


PLAN - VIEW

(Show a minimum of three reference ties to durable physical objects, relevant monuments and physical conditions that will enable recovery of the corner.)

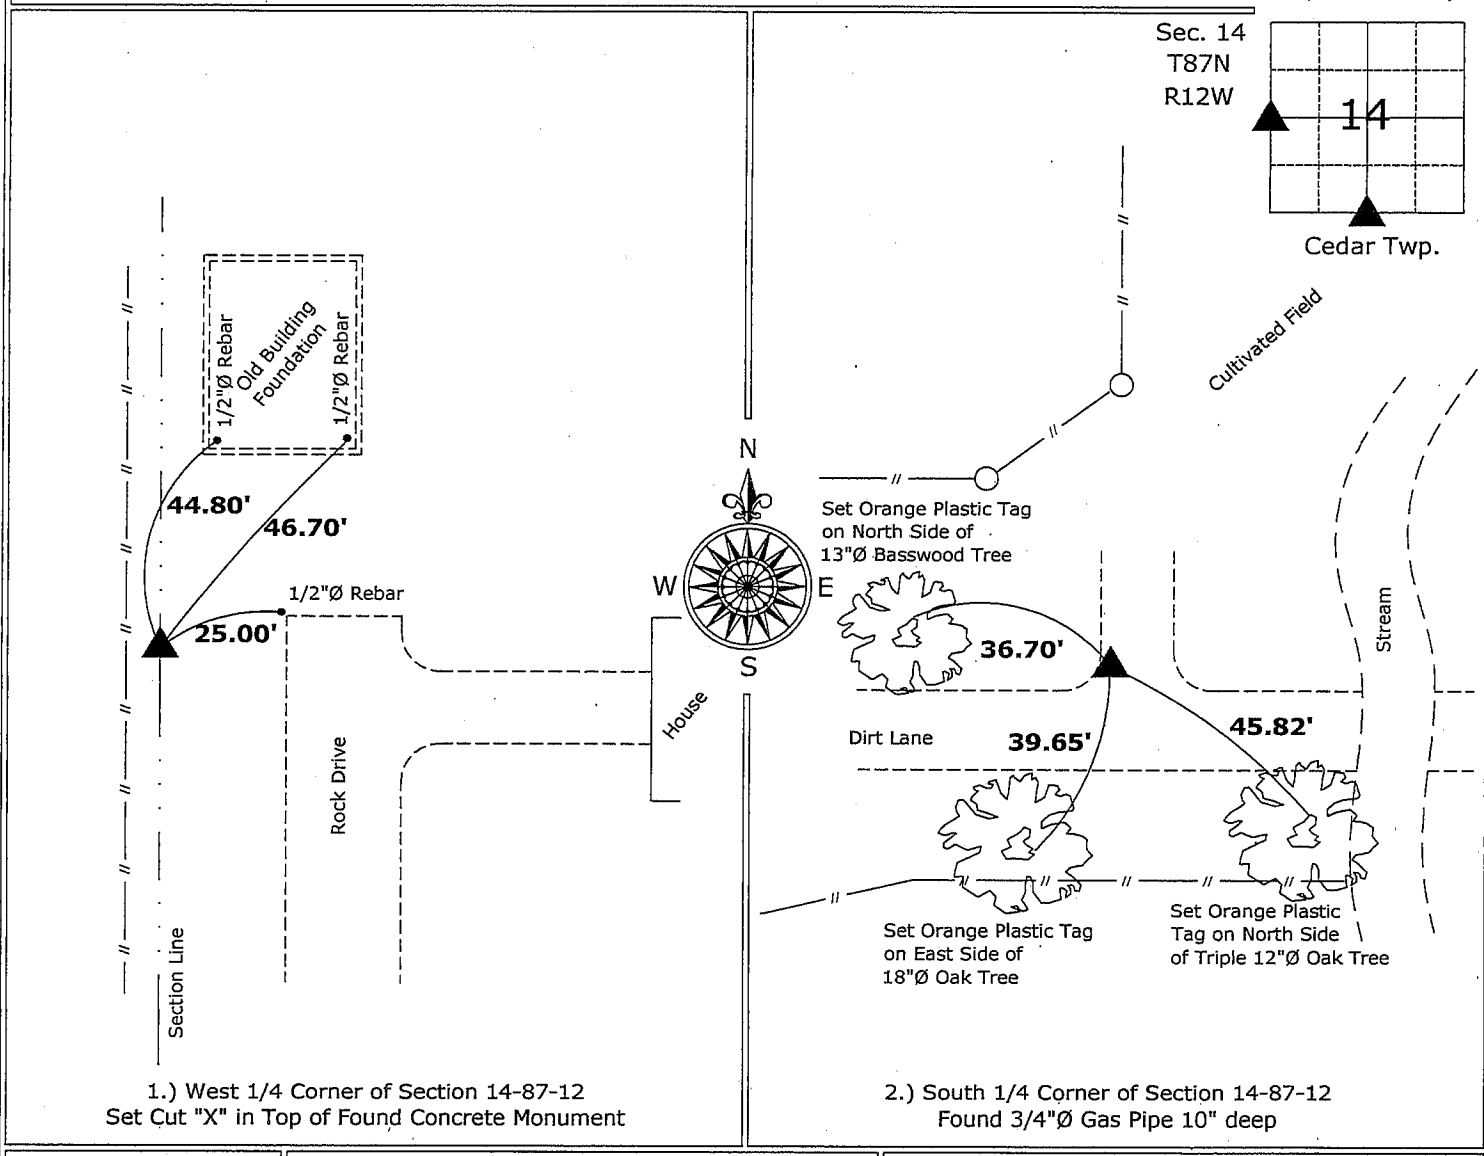

1.) West 1/4 Corner of Section 14-87-12  
Set Cut "X" in Top of Found Concrete Monument

2.) South 1/4 Corner of Section 14-87-12  
Found 3/4"Ø Gas Pipe 10" deep

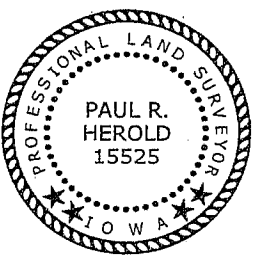

I hereby certify that this land surveying document was prepared and the related survey work was performed by me or under my direct personal supervision and that I am a duly licensed Land Surveyor under the laws of the State of Iowa.

*Paul R. Herold* 9-5-09  
Paul R. Herold Date:

License number 15525  
My license renewal date is December 31, 2010.  
Sheets covered by this seal: Individual sheet only

List Corners to be Indexed			
Corners	Section	Twp.	Range
W 1/4	14	87	12
S 1/4	14	87	12
Project Number: 2009-098			
FB: Black Hawk County 1, Pgs. 8-9			