

Jeffrey P. Helland, 1107 Technology Parkway, Cedar Falls, Iowa 50613-6951, (319)-266-0161

UNITED STATES PUBLIC LAND SURVEY CORNER CERTIFICATE
OFLAND SURVEY MONUMENTS SITUATED IN SECTION NO. 16, TOWNSHIP NO. 87 NORTH, RANGE
NO. 12 WEST OF THE FIFTH PRINCIPAL MERIDIAN, BLACK HAWK COUNTY, IOWA.PREVIOUSLY RECORDED IN N/A(SHOW REASON FOR PREPARING THIS CERTIFICATE, THE EVIDENCE AND DETAILED PROCEDURES USED IN ESTABLISHING THE
CORNER POSITIONS AND MONUMENTATION FOUND OR PLACED.)


MONUMENT DESCRIPTION AND REMARKS:

NO USPLSCC ON FILE. SURVEY COMPLETED IN THE SE 1/4 OF SEC. 9-T87N-R12W.


→ **N 1/4 CORNER:** BLACK HAWK COUNTY ENGINEER REFERENCE TIES CALL FOR [S.C.M.]. WPA CHAINING NOTES DATED 12/7/39 CALL FOR [FOUND NIGGERHEAD 16" x 11" x 7" IRON BAR 3/4" x 18" LOWERED EVIDENCE IN PLACE AND SET CM ON TOP WITH CAP MARKED 9/16 SET TOP OF CM 12" DEEP]. WPA CHAINING NOTES DATED 8/22/41 CALLS FOR [C.M.]. EXCAVATED 2.5'± DEEP HOLE @ RANDOM LINE LOCATION & REMAINING TIE TO NELY WOOD POST (ONLY REMAINING GOOD TIE). PROBED TO A DEPTH OF 4'± AND FOUND NOTHING. BELIEVE C.M. WAS OBLITERATED BY INSTALLATION OF 48"Ø C.M.P. SET NO. 4 REBAR w/ALUMINUM CAP #16264 0.4' DEEP AT RANDOM LINE LOCATION.

(SHOW A MINIMUM OF THREE REFERENCE TIES TO DURABLE PHYSICAL OBJECTS, RELEVANT MONUMENTS AND PHYSICAL
CONDITIONS THAT WILL ENABLE RECOVERY OF THE CORNER.)

PLAN VIEW

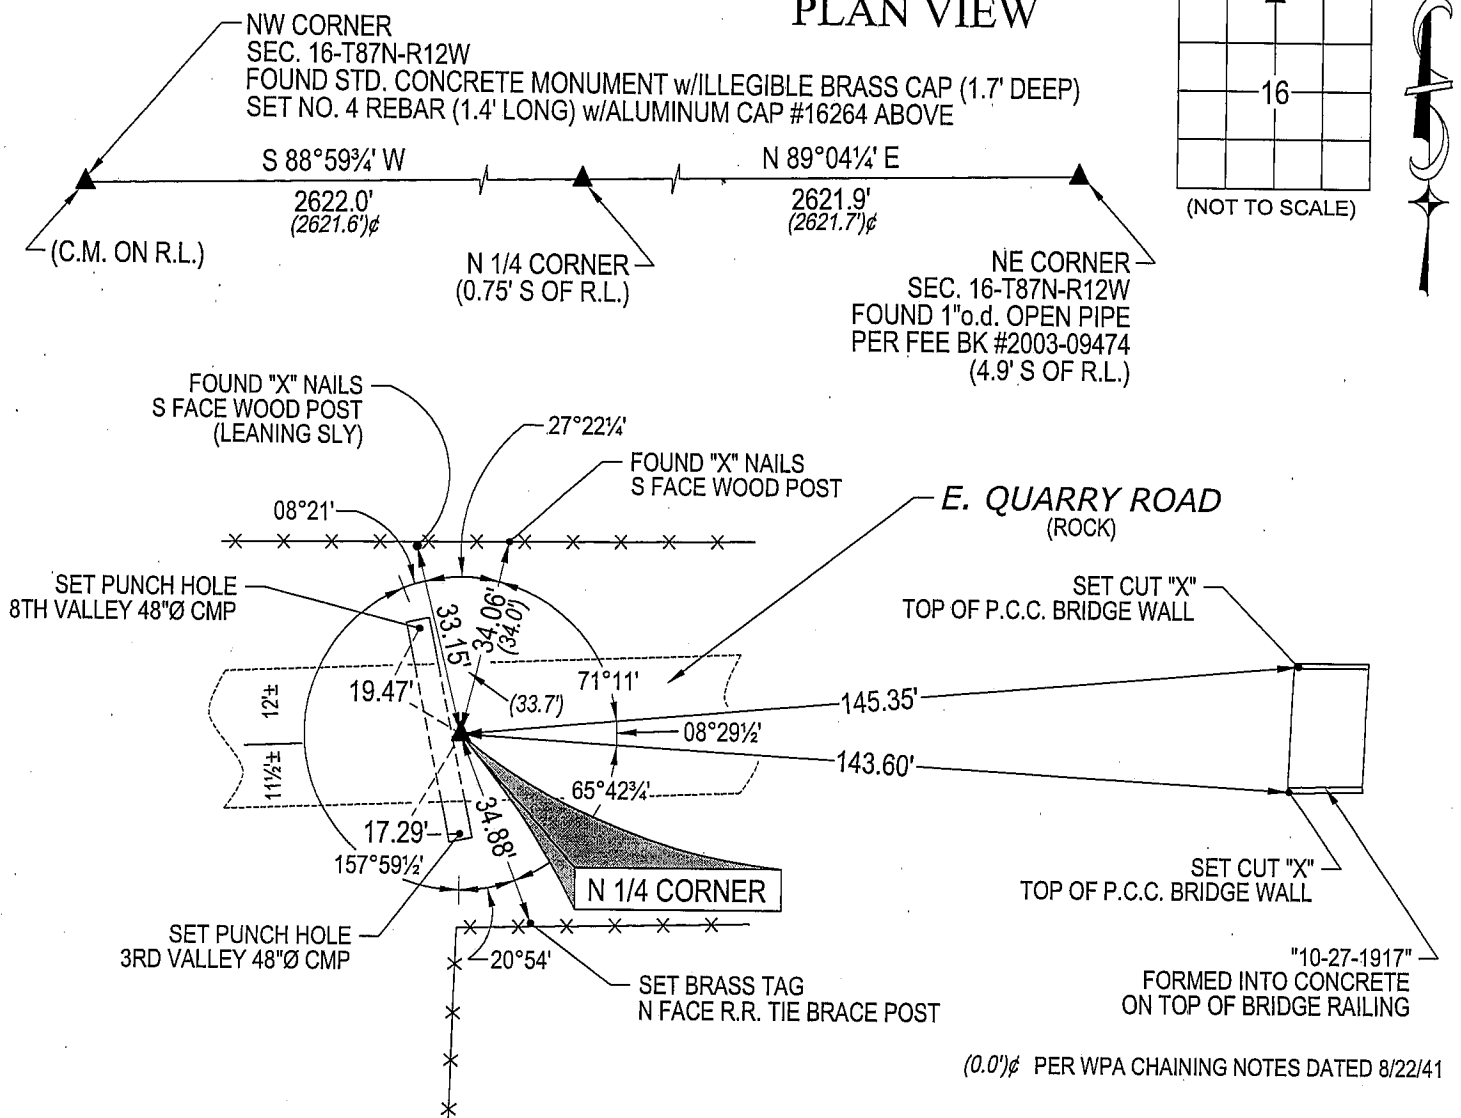

(BEARINGS ARE ASSUMED)

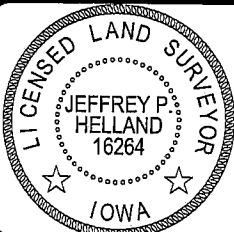HELLAND ENGINEERING & SURVEYING, LTD.
1107 Technology Parkway
Cedar Falls, Iowa 50613-6951
(319)-266-0161SHINER = 8D NAIL & 1 5/16"Ø METAL SHINER
BRASS TAG = 13/16"Ø BRASS TAG
OPC = PLASTIC CAP (O=ORANGE, R=RED, Y=YELLOW)
(00') RECORDED AS FILE NAME: 07-268C2.DWGI hereby certify that this land surveying document was prepared
and the related survey work was performed by me or under my
direct personal supervision and that I am a duly licensed Land
Surveyor under the laws of the State of Iowa.Jeffrey P. Helland 11/28/07
Jeffrey P. Helland
License Number 16264
My license renewal date is December 31, 2007.
All pages or sheets are covered by this seal except

LIST CORNERS TO BE INDEXED

CORNER	SECTION	TOWNSHIP	RANGE
N 1/4 CORNER	16	87N	12W