

REC FEE 5.00
E FEE 2.00
TRAN FEE
REV FEE
GF 7000

Doc ID: 005587820001 Type: GEN
Recorded: 10/01/2014 at 12:08:25 PM
Fee Amt: \$7.00 Page 1 of 1
Black Hawk County Iowa
JUDITH A MCCARTHY RECORDER
File 2015-00005774



UNITED STATES PUBLIC LAND SURVEY CORNER CERTIFICATE
OF

Land Survey Monuments situated in Section 20, Township 87, Range 12 of the Fifth Principal Meridian, BLACK HAWK County, Iowa, previously recorded in FILE: 2012-00001651 in County Recorder's Office. (Book, Page, Document Number, etc.)

Monument Description and Remarks:

FOUND 1/2" UNCAPPED REBAR APPROXIMATELY 1" DEEP IN GRAVEL ROAD AT THE INTERSECTION OF CENTERLINE E. REINBECK RD. AND NORTH/SOUTH FENCE. MONUMENT FOUND MATCHES THAT CALLED FOR IN PREVIOUS TIE. PREVIOUS TIES NO LONGER EXIST. SET NEW TIES AND TIED OUT.

S1/4 CORNER
SECTION 20-T87N-R12W

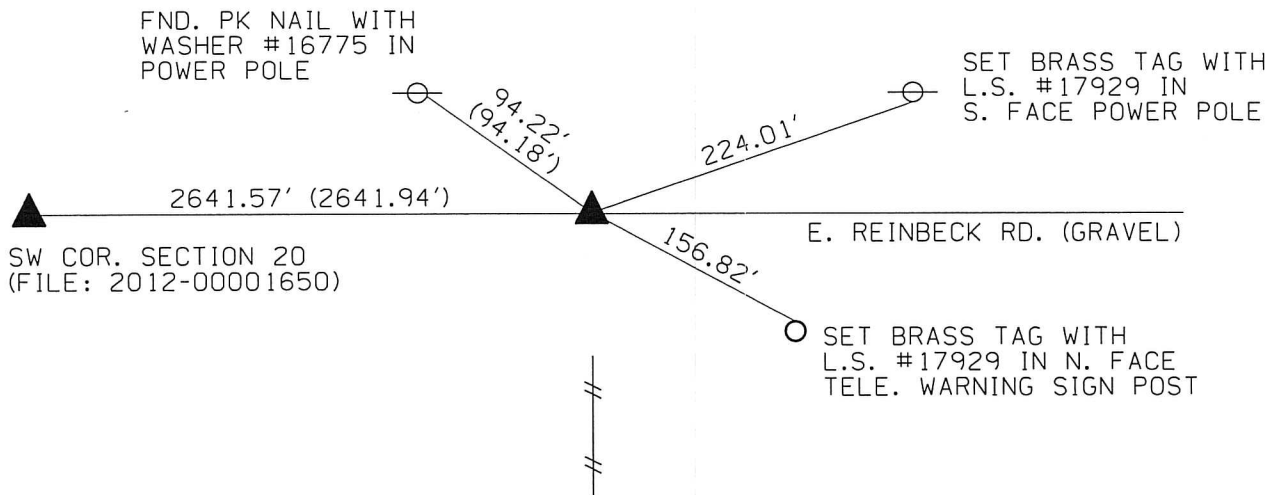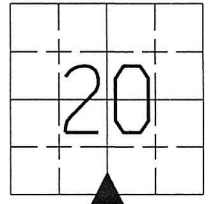

CORNERS TO BE INDEXED
N1/4 SEC. 29-T87N-R12W
S1/4 SEC. 20-T87N-R12W



I hereby certify that this land surveying document was prepared and the related survey work was performed by me or under my direct personal supervision and that I am a duly licensed Land Surveyor under the laws of the State of Iowa.

Jeffrey R. Hutton 9/30/14
JEFFREY R. HUTTON LICENSE NO. 17929 DATE

My license is subject to renewal on December 31, 2015.
This certification applies only to the page upon which it appears.

REASON FOR PREPARING CERTIFICATE:

- ☐ A) THERE IS NO CERTIFICATE FOR THE CORNER ON FILE WITH THE RECORDER OF THE COUNTY IN WHICH THE CORNER IS LOCATED.
- ☐ B) CORNER POSITION DIFFERS FROM THAT SHOWN IN THE PUBLIC RECORDS OF THE COUNTY IN WHICH THE CORNER IS LOCATED.
- ☐ C) THE CORNER MONUMENT HAS BEEN REPLACED OR MODIFIED.
- ☒ D) THE REFERENCE TIES REFERRED TO IN AN EXISTING PUBLIC RECORD ARE INCORRECT.

LEGEND
☐ FENCE POST
☒ WIRE FENCE
☐ RECORD DISTANCE
☒ FOUND MONUMENT

SHEET NAME U.S. LAND SURVEY CORNER CERT.
PROJECT NAME HAGER RETRACEMENT



407 SYCAMORE ST.
LA PORTE CITY, IA 50651
(319)342-4774

REVISION DATE	DRAWN BY MJWH	CHECKED BY MJV	APPROVED BY JRH	DATE 09/26/2014	SCALE NTS	FIELD BOOK No. 1819	PROJECT No. 141024
---------------	---------------	----------------	-----------------	-----------------	-----------	---------------------	--------------------