

Doc ID: 003837070001 Type: GEN
 Recorded: 07/13/2009 at 02:05:21 PM
 Fee Amt: \$9.00 Page 1 of 1
 Instr# 200900001352
 Black Hawk County Iowa
 JUDITH A MCCARTHY RECORDER
 Book 1080 Page 62805 - 62805
 File **2010-00000882**

Jeffrey P. Helland, 1107 Technology Parkway, Cedar Falls, Iowa 50613-6951, (319)-266-0161

UNITED STATES PUBLIC LAND SURVEY CORNER CERTIFICATE OF

LAND SURVEY MONUMENTS SITUATED IN SECTION NO. 26, TOWNSHIP NO. 87 NORTH, RANGE NO. 12 WEST OF THE FIFTH PRINCIPAL MERIDIAN, BLACK HAWK COUNTY, IOWA.
 PREVIOUSLY RECORDED IN N/A

(SHOW REASON FOR PREPARING THIS CERTIFICATE, THE EVIDENCE AND DETAILED PROCEDURES USED IN ESTABLISHING THE CORNER POSITIONS AND MONUMENTATION FOUND OR PLACED.)


MONUMENT DESCRIPTION AND REMARKS:

NO USPLSCC ON FILE. SURVEY COMPLETED IN THE NE 1/4 OF THE SE 1/4 OF SEC. 26-T87N-R12W.

→ NE CORNER OF NW 1/4 SE 1/4: NO BLACK HAWK COUNTY ENGINEER REFERENCE TIES AVAILABLE. FINAL PLAT OF "SUNSET KNOLLS SIXTH ADDITION" DATED 11/7/1978 STATES [SECTION CORNER FOUND]. FINAL PLAT OF "SUNSET KNOLLS NINTH ADDITION" DATED 10/15/2001 CALLS FOR [FOUND 1" CLIPPED STEEL PIPE]. FOUND 1 1/4" o.d. IRON PINCHED PIPE FLUSH w/GROUND SURFACE.

PLAN VIEW

(SHOW A MINIMUM OF THREE REFERENCE TIES TO DURABLE PHYSICAL OBJECTS, RELEVANT MONUMENTS AND PHYSICAL CONDITIONS THAT WILL ENABLE RECOVERY OF THE CORNER.)

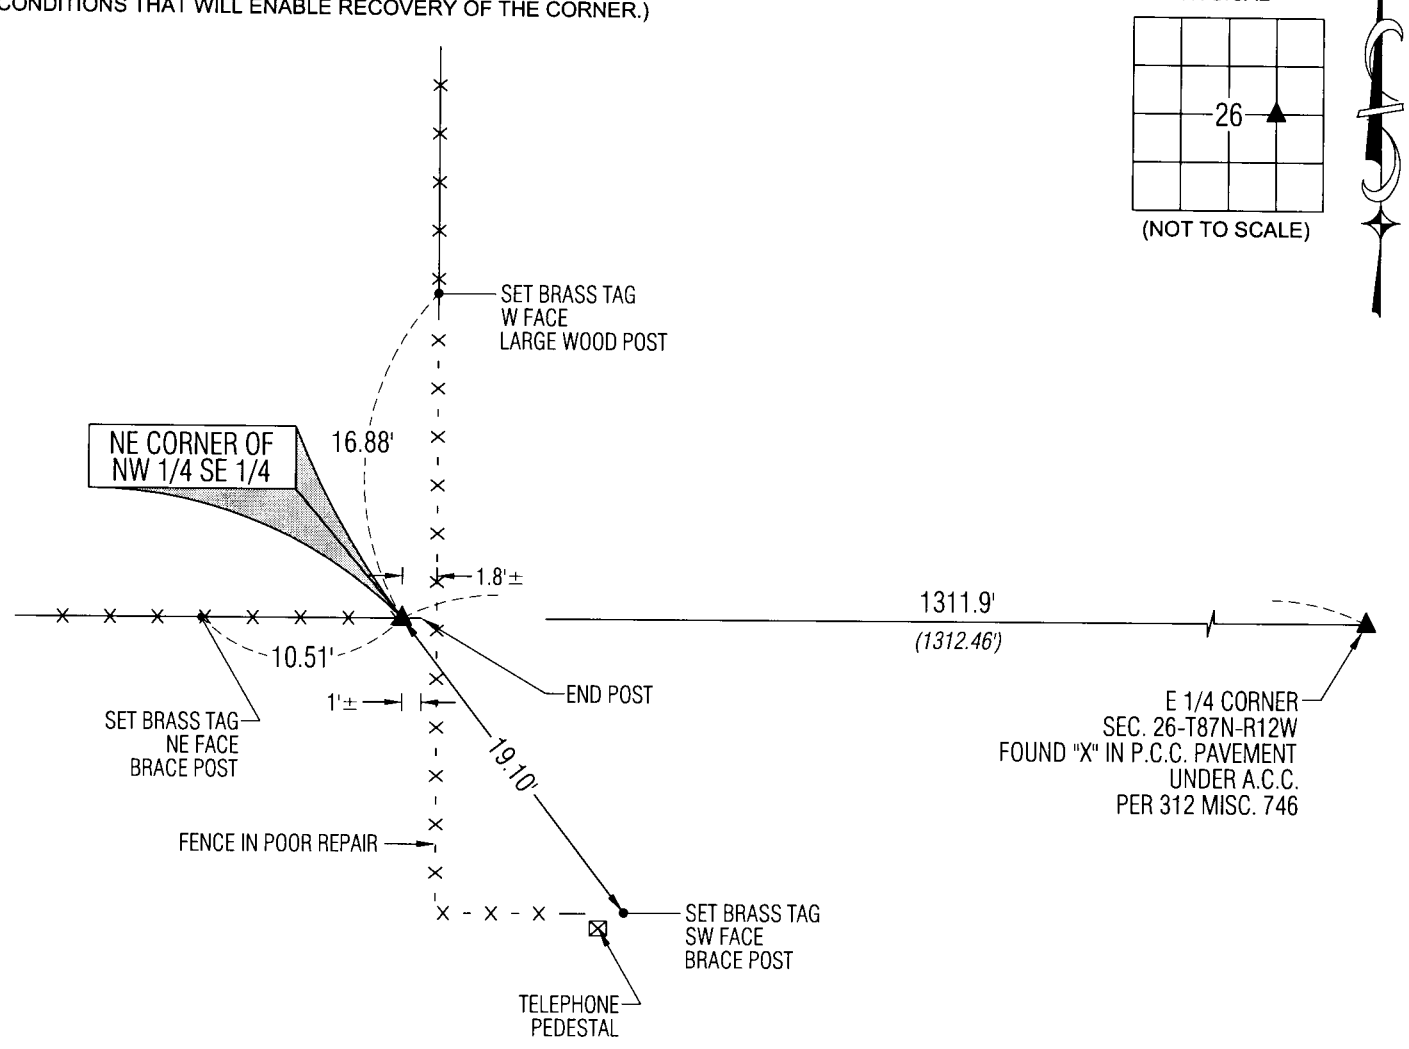

(BEARINGS ARE ASSUMED)

HELLAND ENGINEERING & SURVEYING, LTD.
 1107 Technology Parkway
 Cedar Falls, Iowa 50613-6951
 (319)-266-0161

SHINER = 8D NAIL & 1 5/16" Ø METAL SHINER
 BRASS TAG = 13/16" Ø BRASS TAG
 OPC = PLASTIC CAP (O=ORANGE, R=RED, Y=YELLOW)
 (00') RECORDED AS FILE NAME: 08-250C1.DWG

I hereby certify that this land surveying document was prepared and the related survey work was performed by me or under my direct personal supervision and that I am a duly licensed Land Surveyor under the laws of the State of Iowa.
Jeffrey P. Helland 8/15/08
 Jeffrey P. Helland
 License Number 16264
 My license renewal date is December 31, 2009.
 All pages or sheets are covered by this seal except:

CORNER	SECTION	TOWNSHIP	RANGE
NE CORNER NW 1/4 SE 1/4	26	87N	12W

11170 \$900