

PROOF

FILED FOR RECORD MAY 26, 2006, AT 11:00 A.M. FEE 1-5.00/-1.00/

COMPARED




BLACK HAWK COUNTY RECORDER

PRANGE SURVEYING 3304 PANTHER LANE CEDAR FALLS IA 50613

Prepared by Dennis R. Prange, L.S., Prange Surveying, 3304 Panther Lane, Cedar Falls, Iowa 50613, (319) 277-4935

UNITED STATES PUBLIC LAND SURVEY CORNER CERTIFICATE  
OFLand Survey Monuments situated in Section No. 27, Township No. 87 North, Range  
No. 12 West, of the Fifth Principal Meridian, Black Hawk County, Iowa.Previously recorded in Book N/A on Page        in the office of the County Recorder.  
(book, page, document number, etc.)(Show reason for preparing this certificate, the evidence and detailed procedures used in establishing the corner positions and  
monumentation found or placed.)Monument Description and Remarks: West 1/4 Corner Sec. 27-87-12 - Found concrete  
monument 24" deep. Set 1/2"Ø X 18" rebar with cap no. 10040 above.

## PLAN - VIEW

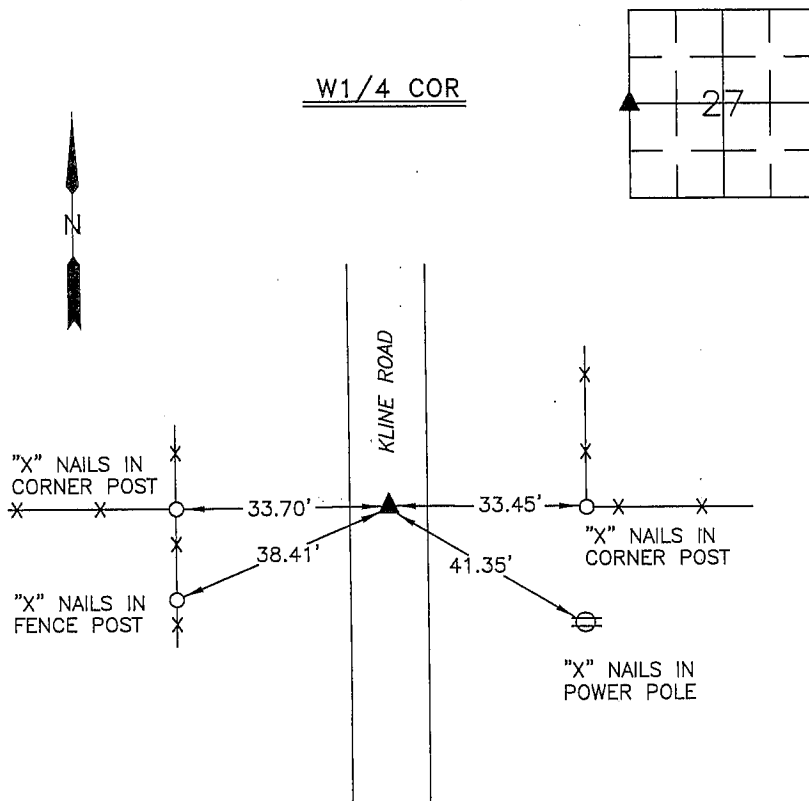(Show a minimum of three reference ties to durable physical objects, relevant monuments and physical conditions that will enable  
recovery of the corner.)NOT TO SCALEW1/4 COR

ALL TIES ARE HORIZONTAL DISTANCES


I hereby certify that this land surveying document was prepared  
by me or under my direct personal supervision and that I am  
a duly licensed Professional Land Surveyor under the laws of  
the State of Iowa.Signed: 

Dennis R. Prange, L.S.

Iowa License No. 10040

Date: May 25, 2006

SEAL

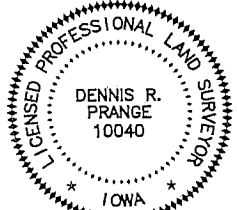

My License renewal date is December 31, 2006.

Pages or sheets covered by this seal : this page only

Corners	List Corners to be Indexed Section	Twp	Range
W1/4 COR	27	87	12

Drawn by: DRP

Checked by: