

REC FEE 5.00
E FEE 2.00
TRAN FEE _____
REV FEE _____
GF _____
9/21



Doc ID: 005587840001 Type: GEN
Recorded: 10/01/2014 at 12:08:37 PM
Fee Amt: \$7.00 Page 1 of 1
Black Hawk County Iowa
JUDITH A MCCARTHY RECORDER

File **2015-00005776**

UNITED STATES PUBLIC LAND SURVEY CORNER CERTIFICATE
OF



Land Survey Monuments situated in Section 27, Township 87, Range 12 of the Fifth Principal Meridian, BLACK HAWK County, Iowa, previously recorded in N/A
(Book, Page, Document Number, etc.)

Monument Description and Remarks:

SEARCHED FOR MONUMENT AT A POINT 1/4 MILE E. OF THE SW COR. SW1/4 SEC. 27. DID NOT FIND ANY EXISTING MONUMENT. SET "SURVEY MARK" NAIL IN ACC ROADWAY OF E. TAMA RD. AT A POINT EQUAL DISTANCE BETWEEN THE SW COR. SW1/4 (MISC. BOOK 332, PAGE 492) AND THE SE COR. SW1/4 (MISC. BOOK 332, PAGE 491).

SE COR. SW1/4 SW1/4
SECTION 27-T87N-R12W

① SET BRASS TAG WITH L.S. #17929

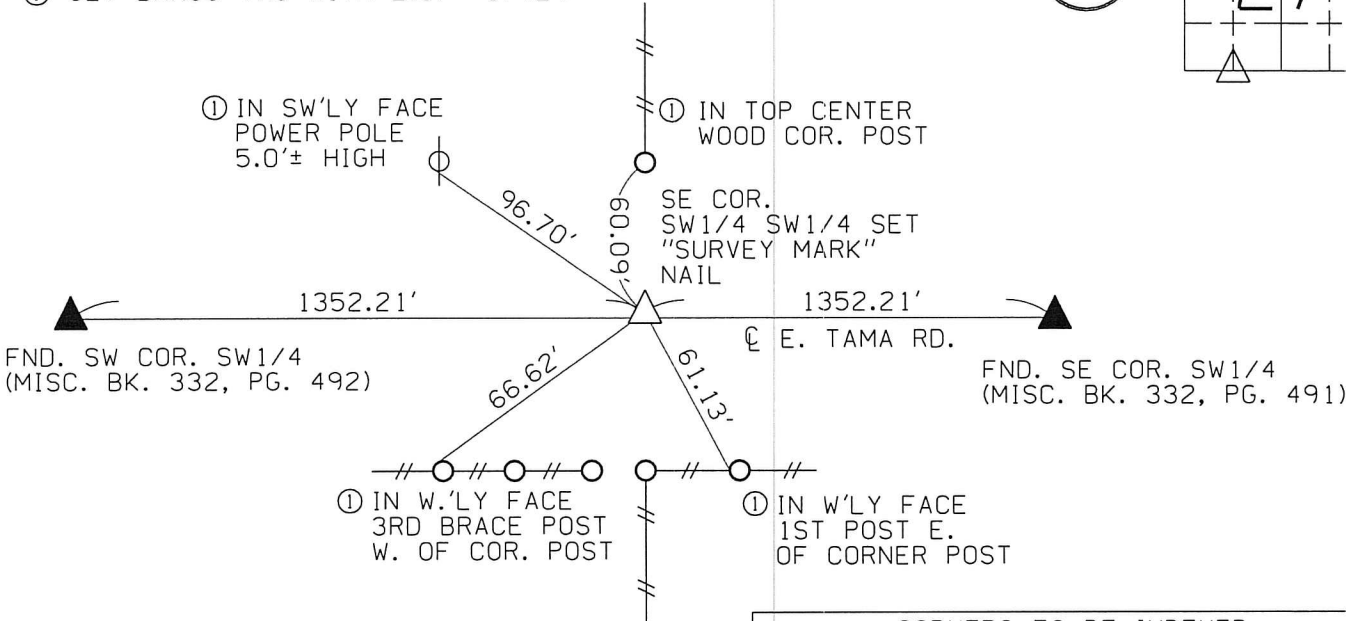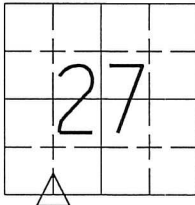

CORNERS TO BE INDEXED

SE COR. SW1/4 SW1/4 SEC. 27-T87N-R12W
NE COR. NW1/4 SW1/4 SEC. 34-T87N-R12W



I hereby certify that this land surveying document was prepared and the related survey work was performed by me or under my direct personal supervision and that I am a duly licensed Land Surveyor under the laws of the State of Iowa.

Jeffrey R. Hutton 9/30/14
JEFFREY R. HUTTON LICENSE NO. 17929 DATE

My license is subject to renewal on December 31, 2015.
This certification applies only to the page upon which it appears.

REASON FOR PREPARING CERTIFICATE:

- ☒ A) THERE IS NO CERTIFICATE FOR THE CORNER ON FILE WITH THE RECORDER OF THE COUNTY IN WHICH THE CORNER IS LOCATED.
☐ B) CORNER POSITION DIFFERS FROM THAT SHOWN IN THE PUBLIC RECORDS OF THE COUNTY IN WHICH THE CORNER IS LOCATED.
☒ C) THE CORNER MONUMENT HAS BEEN REPLACED OR MODIFIED.
☐ D) THE REFERENCE TIES REFERRED TO IN AN EXISTING PUBLIC RECORD ARE INCORRECT.

LEGEND
○ FENCE POST
-- WIRE FENCE

SHEET NAME U.S. LAND SURVEY CORNER CERT.
PROJECT NAME HAGER RETRACEMENT



407 SYCAMORE ST.
LA PORTE CITY, IA 50651
(319)342-4774

REVISION DATE	DRAWN BY MJWH	CHECKED BY MJV	APPROVED BY JRH	DATE 09/26/2014	SCALE NTS	FIELD BOOK No. 1819	PROJECT No. 141024
---------------	---------------	----------------	-----------------	-----------------	-----------	---------------------	--------------------