



Doc ID: 007590050001 Type: GEN
 Recorded: 04/03/2017 at 04:28:18 PM
 Fee Amt: \$7.00 Page 1 of 1
 Black Hawk County Iowa
 SANDIE L. SMITH RECORDER

File **2017-00017067**

Reserved for County Recorder's use.

*Kyle J. Helland, 1107 Technology Parkway, Cedar Falls, Iowa 50613-6951, (319)-266-0161

UNITED STATES PUBLIC LAND SURVEY CORNER CERTIFICATE OF

LAND SURVEY MONUMENTS SITUATED IN SECTION NO. 28, TOWNSHIP NO. 87 NORTH, RANGE
 NO. 12 WEST OF THE FIFTH PRINCIPAL MERIDIAN, BLACK HAWK COUNTY, IOWA.
 PREVIOUSLY RECORDED IN BOOK 312 PAGE 835.

(SHOW REASON FOR PREPARING THIS CERTIFICATE, THE EVIDENCE AND DETAILED PROCEDURES USED IN ESTABLISHING THE
 CORNER POSITIONS AND MONUMENTATION FOUND OR PLACED.)


MONUMENT DESCRIPTION AND REMARKS:

NO REFERENCE TIES REMAIN. SURVEY COMPLETED IN THE SE 1/4 OF SEC. 21-T87N-R12W.

→ **NE CORNER:** USPLSCC MISC. BOOK 312 PAGE 835 DATED 10/05/1994 CALLS FOR [FOUND 1"Ø CLIP PIN 3" DEEP
 IN GRAVEL ROAD PER COUNTY TIES]. SEARCHED AREA, FOUND 1"o.d. IRON PINCHED PIPE 0.5' DEEP.

PLAN VIEW

(SHOW A MINIMUM OF THREE REFERENCE TIES TO DURABLE PHYSICAL OBJECTS, RELEVANT MONUMENTS AND PHYSICAL
 CONDITIONS THAT WILL ENABLE RECOVERY OF THE CORNER.)

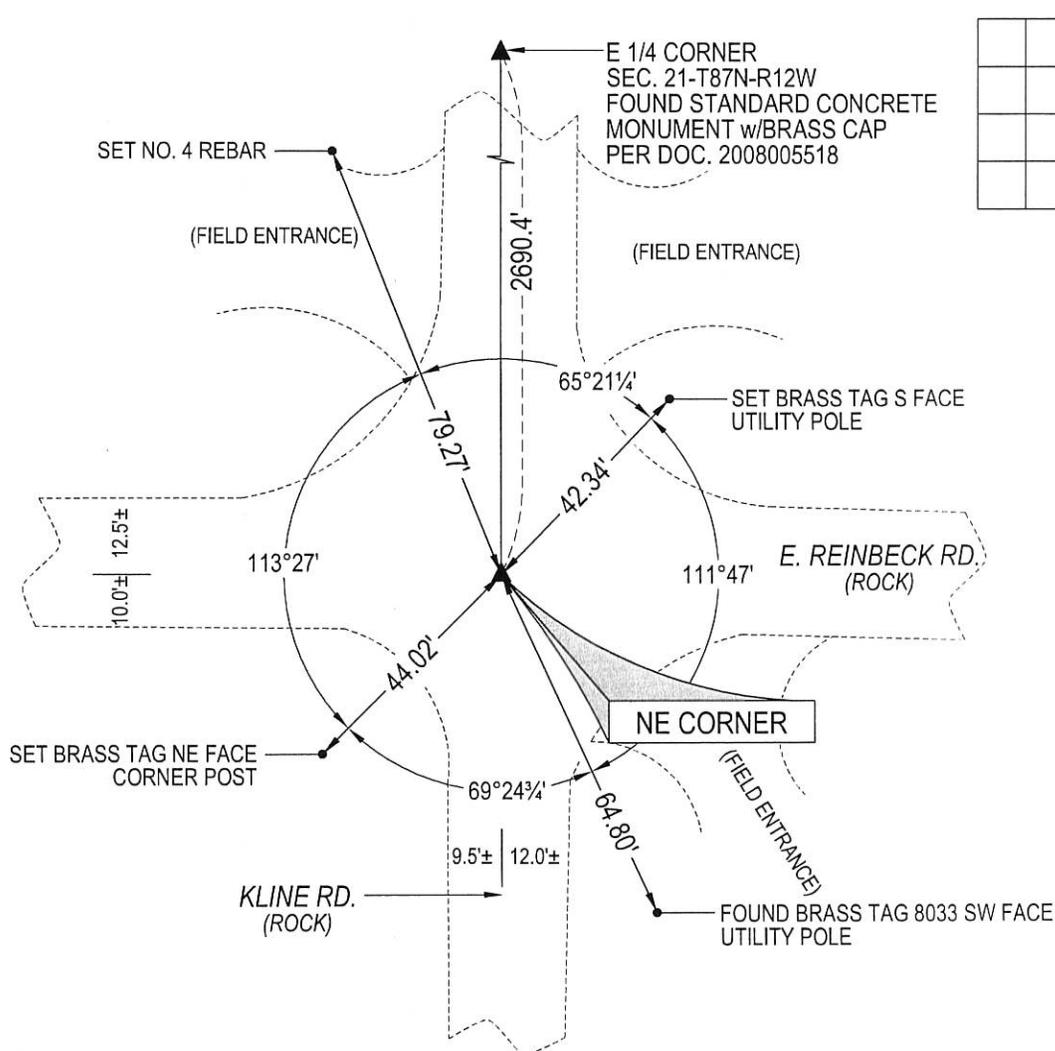

(BEARINGS ARE ASSUMED)



HELLAND ENGINEERING & SURVEYING, LTD.
 1107 Technology Parkway
 Cedar Falls, Iowa 50613-6951
 (319)-266-0161

SHINER = 8d. NAIL & 1 5/16"Ø METAL SHINER DRAWN BY: JBL
 BRASS TAG = 8d. NAIL & 13/16"Ø BRASS TAG
 OPC = PLASTIC CAP (O=ORANGE, R=RED, Y=YELLOW)
 (00) RECORDED AS FILE NAME: 17-129-23.DWG



I hereby certify that this land surveying document was prepared
 and the related survey work was performed by me or under my
 direct personal supervision and that I am a duly licensed
 Professional Land Surveyor under the laws of the State of Iowa.

Kyle J. Helland 4/3/17
 Kyle J. Helland
 License Number 23212
 My license renewal date is December 31, 2017.
 All pages or sheets are covered by this seal except:

LIST CORNERS TO BE INDEXED

CORNER	SECTION	TOWNSHIP	RANGE
NE CORNER	28	87N	12W
SE CORNER	21	87N	12W
SW CORNER	22	87N	12W
NW CORNER	27	87N	12W