

Jeffrey P. Helland, 1107 Technology Parkway, Cedar Falls, Iowa 50613-6951, (319)-266-0161

UNITED STATES PUBLIC LAND SURVEY CORNER CERTIFICATE  
OF

LAND SURVEY MONUMENTS SITUATED IN SECTION NO. 32, TOWNSHIP NO. 87 NORTH, RANGE NO. 12 WEST OF THE FIFTH PRINCIPAL MERIDIAN, BLACK HAWK COUNTY, IOWA.  
PREVIOUSLY RECORDED IN N/A

(SHOW REASON FOR PREPARING THIS CERTIFICATE, THE EVIDENCE AND DETAILED PROCEDURES USED IN ESTABLISHING THE CORNER POSITIONS AND MONUMENTATION FOUND OR PLACED.)


MONUMENT DESCRIPTION AND REMARKS:  
NO USPLSCC ON FILE. SURVEY COMPLETED IN THE NW 1/4 OF SEC. 33-T87N-R12W.

W 1/4 CORNER: W.P.A. NOTES DATED 8/29/1941 CALL FOR [FOUND LIMESTONE 16"x9"x4" AND IRON BAR 1/2"x16" LOWERED ALL EVIDENCE IN PLACE AND SET C.M. WITH CAP MARKED.....SET TOP OF C.M. 12" DEEP]. FOUND CONCRETE MONUMENT w/BRASS CAP 0.6' DEEP. ALSO FOUND 60d SPIKE 0.25' W OF SAID C.M., 0.4' DEEP. UTILIZED SAID CONCRETE MONUMENT AS CORNER.

(SHOW A MINIMUM OF THREE REFERENCE TIES TO DURABLE PHYSICAL OBJECTS, RELEVANT MONUMENTS AND PHYSICAL CONDITIONS THAT WILL ENABLE RECOVERY OF THE CORNER.)


PLAN VIEW

DETAIL OF CAP

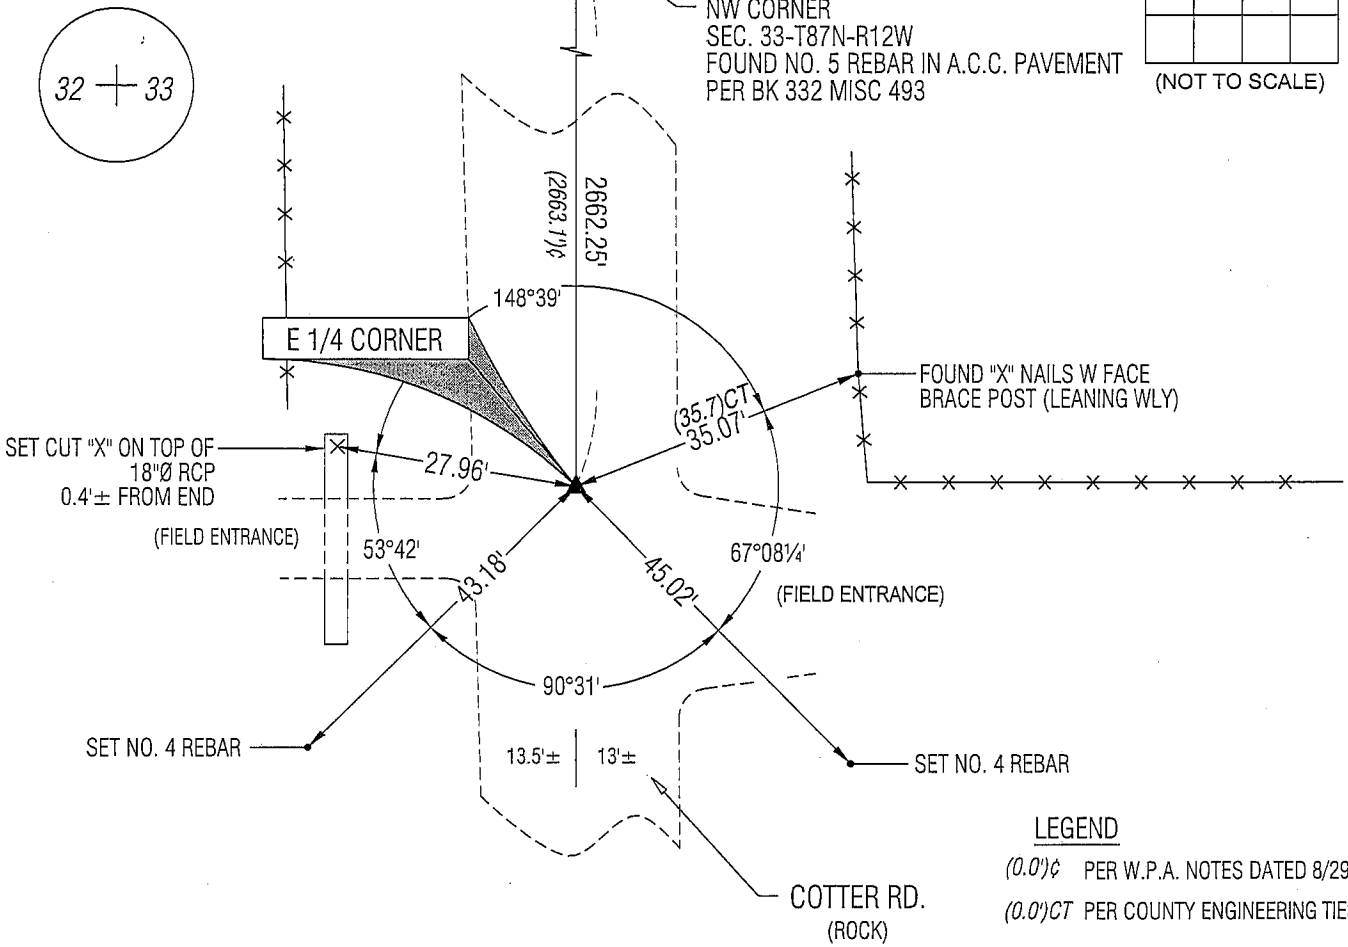

**HES** HELLAND ENGINEERING & SURVEYING, LTD.  
1107 Technology Parkway  
Cedar Falls, Iowa 50613-6951  
(319)-266-0161

SHINER = 8D NAIL & 1 5/16"Ø METAL SHINER  
BRASS TAG = 13/16"Ø BRASS TAG  
OPC = PLASTIC CAP (O=ORANGE, R=RED, Y=YELLOW)  
(00) RECORDED AS FILE NAME: 08-189C2.DWG

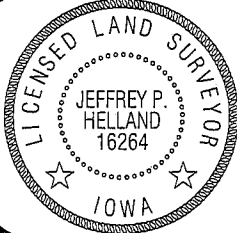

I hereby certify that this land surveying document was prepared and the related survey work was performed by me or under my direct personal supervision and that I am a duly licensed Land Surveyor under the laws of the State of Iowa.  
Jeffrey P. Helland 6/5/08  
Jeffrey P. Helland  
License Number 16264  
My license renewal date is December 31, 2009.  
All pages or sheets are covered by this seal except:

LIST CORNERS TO BE INDEXED			
CORNER	SECTION	TOWNSHIP	RANGE
E 1/4 CORNER	32	87N	12W
W 1/4 CORNER	33	87N	12W

Rec!