

Jeffrey P. Helland, 1107 Technology Parkway, Cedar Falls, Iowa 50613-6951, (319)-266-0161

UNITED STATES PUBLIC LAND SURVEY CORNER CERTIFICATE  
OFLAND SURVEY MONUMENTS SITUATED IN SECTION NO. 33, TOWNSHIP NO. 87 NORTH, RANGE  
NO. 12 WEST OF THE FIFTH PRINCIPAL MERIDIAN, BLACK HAWK COUNTY, IOWA.  
PREVIOUSLY RECORDED IN USPLSCC BK 332 PG 494(SHOW REASON FOR PREPARING THIS CERTIFICATE, THE EVIDENCE AND DETAILED PROCEDURES USED IN ESTABLISHING THE  
CORNER POSITIONS AND MONUMENTATION FOUND OR PLACED.)

## MONUMENT DESCRIPTION AND REMARKS:

USPLSCC BK 332 PG 494 REFERENCE TIES HAVE CHANGED. SURVEY COMPLETED IN THE NW 1/4 OF SEC. 33-T87N-R12W.

→ **NE CORNER:** BLACK HAWK COUNTY ENGINEER REFERENCE TIES CALL FOR [PLACED 2.0' I.P. TO SURF.] W.P.A. NOTES  
DATED 8/29/1941 CALLS FOR [C.M.]. USPLSCC BK 332 PG 494 DATED 12/5/1998 CALLS FOR [FOUND RESET 5/8"  
REBAR.....2.5' SOUTH OF CL TAMA RD. @ INT. WITH COTTER RD.] FOUND NO. 5 REBAR IN A.C.C. PAVEMENT 2.5'± SOUTH OF  
CL CORRESPONDS WITHIN REASON TO TWO REMAINING TIES. UTILIZED SAID REBAR AS CORNER.

(SHOW A MINIMUM OF THREE REFERENCE TIES TO DURABLE PHYSICAL OBJECTS, RELEVANT MONUMENTS AND PHYSICAL  
CONDITIONS THAT WILL ENABLE RECOVERY OF THE CORNER.)

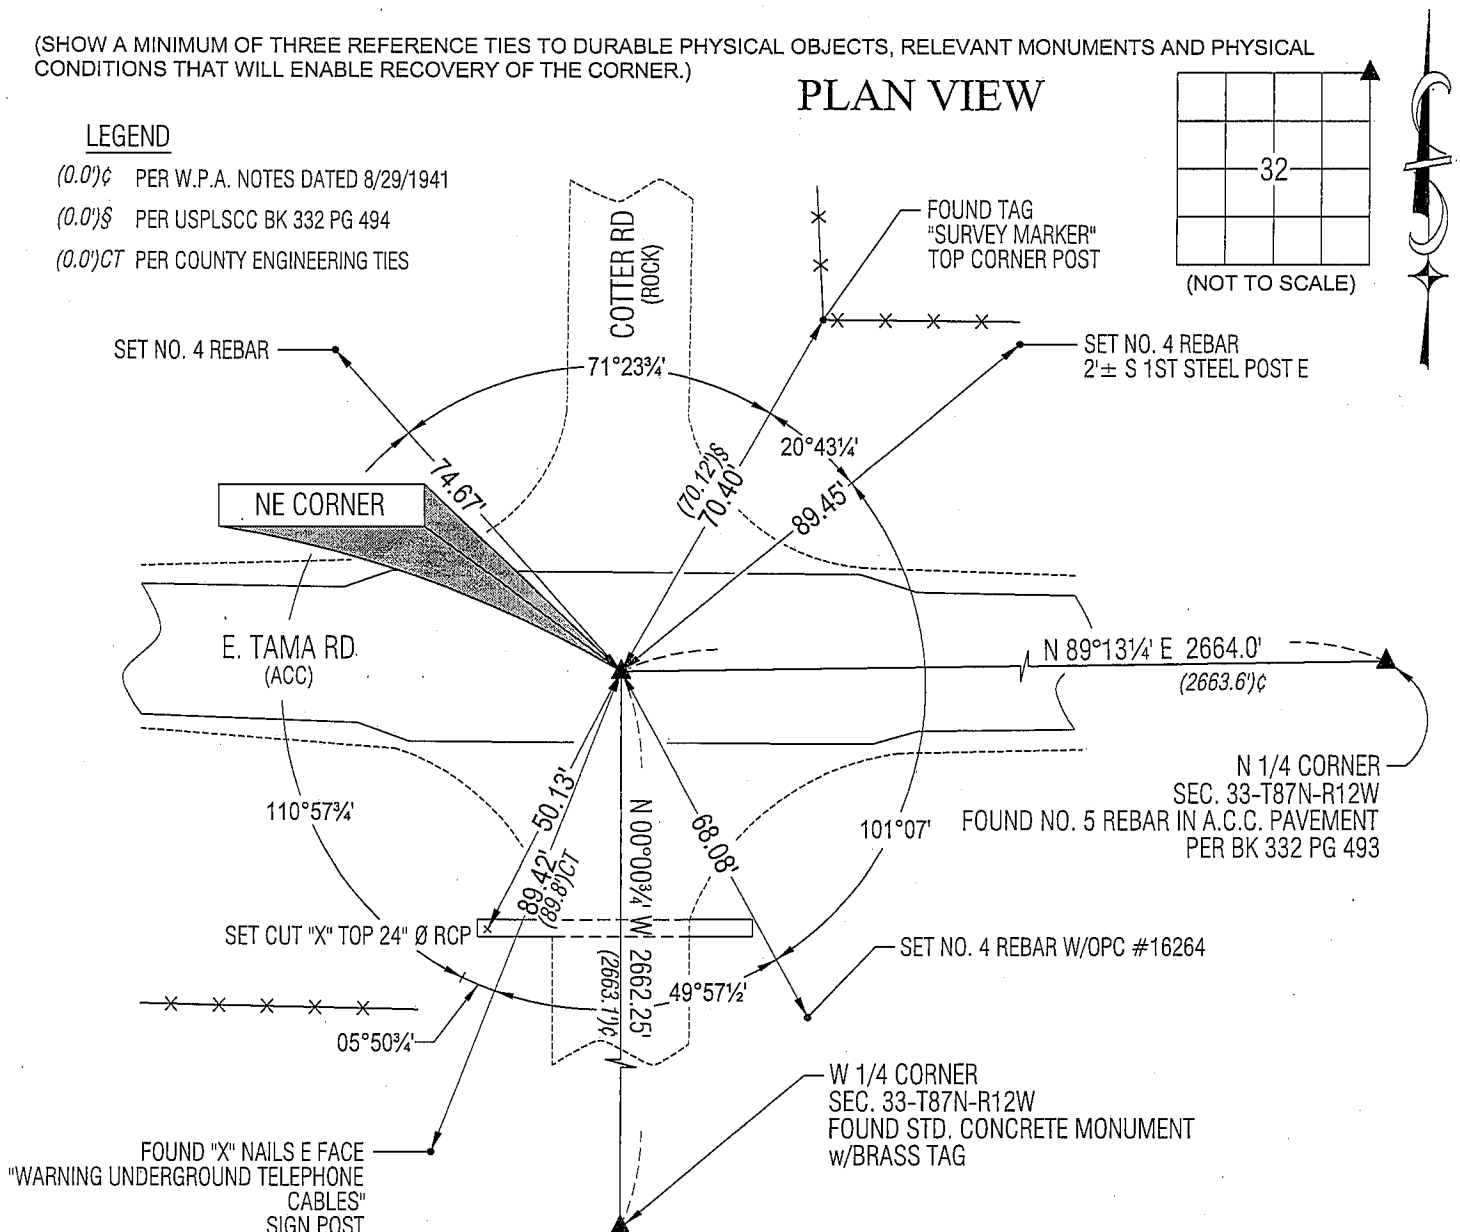
## LEGEND

(0.0')C PER W.P.A. NOTES DATED 8/29/1941

(0.0')S PER USPLSCC BK 332 PG 494

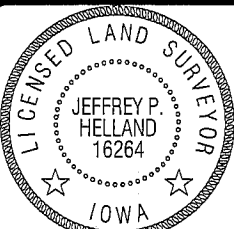
(0.0')CT PER COUNTY ENGINEERING TIES

## PLAN VIEW

HELLAND ENGINEERING & SURVEYING, LTD.  
1107 Technology Parkway  
Cedar Falls, Iowa 50613-6951  
(319)-266-0161SHINER = 8D NAIL & 1 5/16"Ø METAL SHINER  
BRASS TAG = 13/16"Ø BRASS TAG  
OPC = PLASTIC CAP (O=ORANGE, R=RED, Y=YELLOW)  
(00') RECORDED AS FILE NAME: 08-189C1.DWG

## LIST CORNERS TO BE INDEXED

CORNER	SECTION	TOWNSHIP	RANGE
NW CORNER	33	87	12W
NE CORNER	32	87	12W
SW CORNER	28	87	12W
SE CORNER	29	87	12W

I hereby certify that this land surveying document was prepared  
and the related survey work was performed by me or under my  
direct personal supervision and that I am a duly licensed Land  
Surveyor under the laws of the State of Iowa.Jeffrey P. Helland 6/5/08  
Jeffrey P. Helland  
License Number 16264  
My license renewal date is December 31, 2009.  
All pages or sheets are covered by this seal except:

Rec.