

2025-10524

RECORDED: 07/23/2025 08:30:39 AM

RECORDING FEE: \$0.00

REVENUE TAX: \$

COMBINED FEE: \$0.00

SANDIE L. SMITH, RECORDER  
BLACK HAWK COUNTY, IOWA

\*Black Hawk County Engineer's Office

Prepared by & Return to: Isaiah M. Reicks, HRS, LLC, 2206 East Bremer Avenue, Waverly, IA 50677, Phone 319-493-5187

### United States Public Land Survey Corner Certificate

Land Survey Monument situated in  
Section 33, Township 87 North, Range 12 West of the Fifth Principal Meridian, Black Hawk County, Iowa  
On file in Book 332, Page 494 in the County Recorder's Office

This certificate is being prepared in compliance with Iowa Code Chapter 355 11 because

- There is no certificate on file for this corner
- There are no longer three valid ties of record
- There are changes to reference ties of record
- There is change of monumentation of record
- To clarify description of record monument (ties)


#### Monument Description and Remarks.

##### NW Corner

Found 5/8"Ø Rebar with information obtained from the previously recorded Section Corner Certificate  
Set 1"Ø Bronze Survey Marker PLS 22468 with coordinates of the found location obtained prior to highway reconstruction  
Corner reset in conjunction with Project No FM-C007(174)--55-07


### Plan View - Not to Scale

(Show a minimum of three reference ties to durable physical objects, relevant monuments and physical conditions that will enable recovery of the corner)

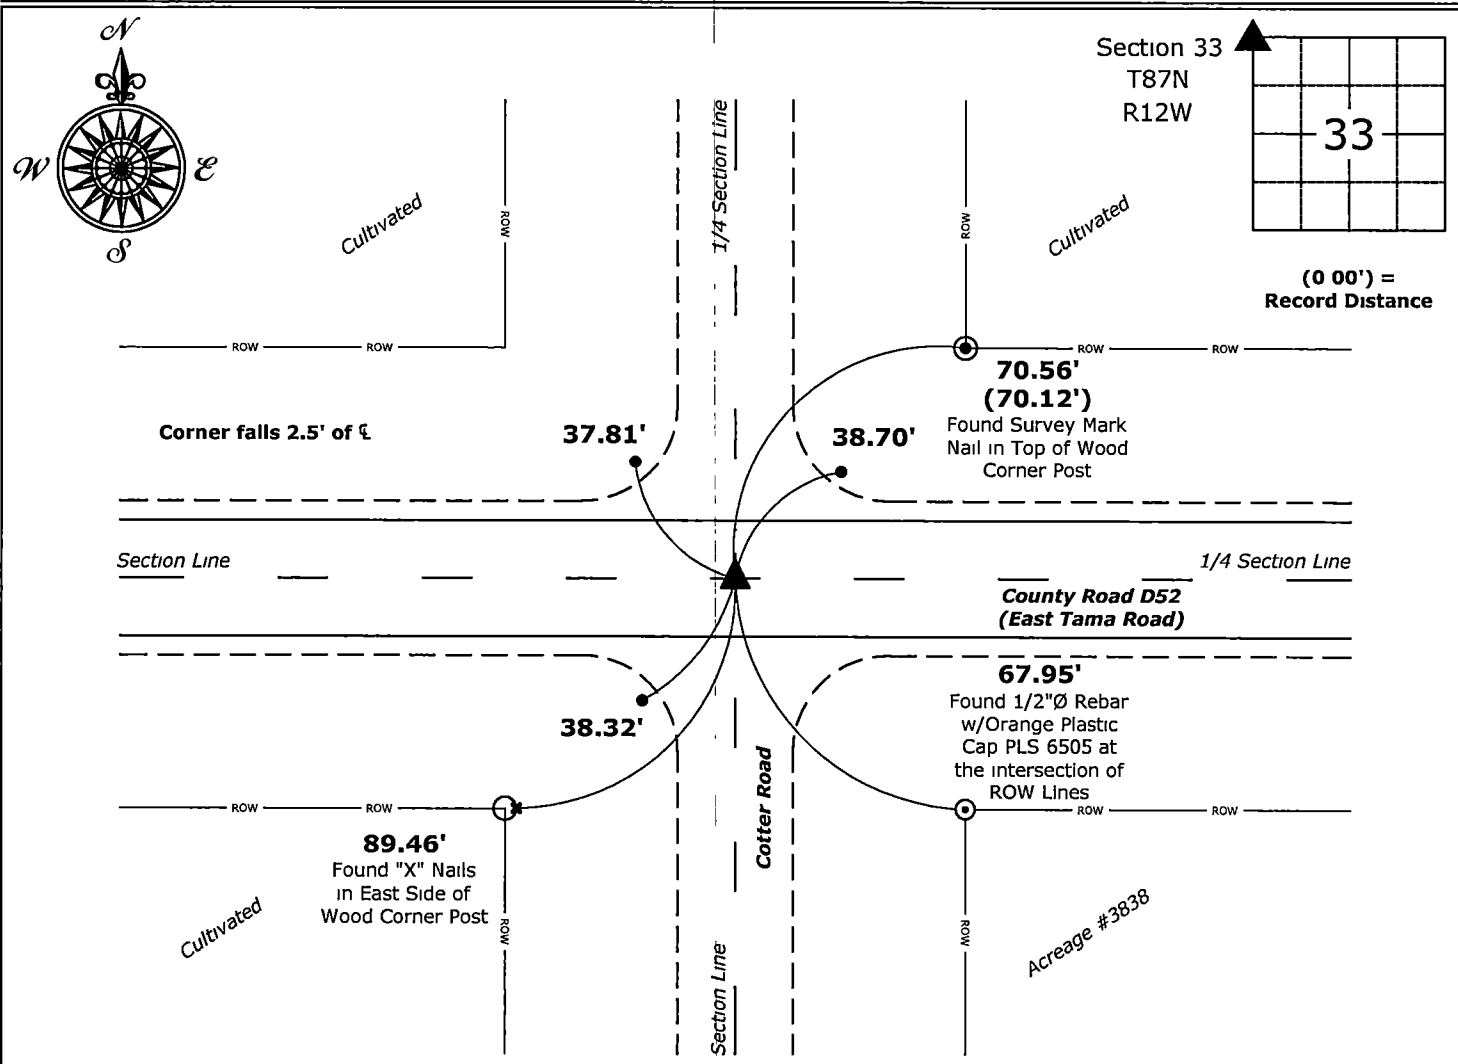

● = Set 5/8"Ø Rebar at the Edge of Shoulder at Mid-Radius (3 Typical)

**NW Corner of Section 33-87-12**  
Set 1"Ø Bronze Survey Marker PLS 22468

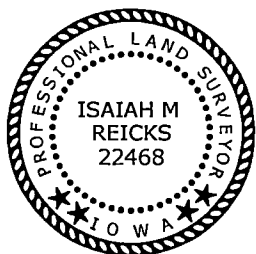

I hereby certify that this land surveying document was prepared and the related survey work was performed by me or under my direct personal supervision and that I am a duly licensed Land Surveyor under the laws of the State of Iowa

*Isaiah M. Reicks* 7-10-25  
Isaiah M Reicks Date

License number 22468  
My license renewal date is December 31, 2025  
Sheets covered by this seal Individual sheet only

#### List Corner to be Indexed

Corner	Section	Township	Range
NW	33	87	12

Project Number 2025-505

FB Black Hawk 12, Page(s) 30-31