

BLACK HAWK COUNTY IOWA:SS Filed for record $\underline{\text{Dec }7}$, 1998 at 133664:00 P .M. and recorded in Book 332

Page 491

N/ Engineer's Office 🙍 Recorder

PREPARED BY:

BLACK HAWK COUNTY ENGINEERS OFFICE

WATERLOO, IOWA

PH.# (319) 291-2419 FAX.# (319) 291-2461

SISI 9-94 CERT 12-96

UNITED STATES PUBLIC LAND SURVEY CORNER CERTIFICATE OF


Land Survey Monuments situated in Section_ 34 _, Township<u>87 N</u> Range 12 W , of the Fifth Principal Meridian, BLACK HAWK County, Iowa. Previously recorded in Misc. Book N/A, Page N/A, in County Recorder's Office.

(Show reason for preparing this certificate, the evidence and detailed procedures used in establishing the corner positions and monumentation found or placed.)

Monument Description and Remarks: N. 1/4 CORNER SECT. 34-87-12 AFTER RESUF., FOUND 5/8' REBAR FLUSH WITH A.C.C. SURFACE AND LOCATED 9.5' S. OF N. EDGE RD. SURFACE AND ALIGNED WITH FENCE ROW TO NORTH. REF. TIES FROM NOV. 1967 NOT RECOVERED DUE TO POSSIBLE R.O.W. CHANGES. HOWEVER, FIELD RECOVERED AND REF. ONE SET OF REF. TIES FROM UNKNOWN RE-TIED FROM 1995 RESURF, PROJ. AND REF. TIE UPDATE SPRING 1997.

PLAN - VIEW

(Show a minimum of three reference ties to durable physical objects, relevant monuments and physical conditions that will enable recovery of the corner.)

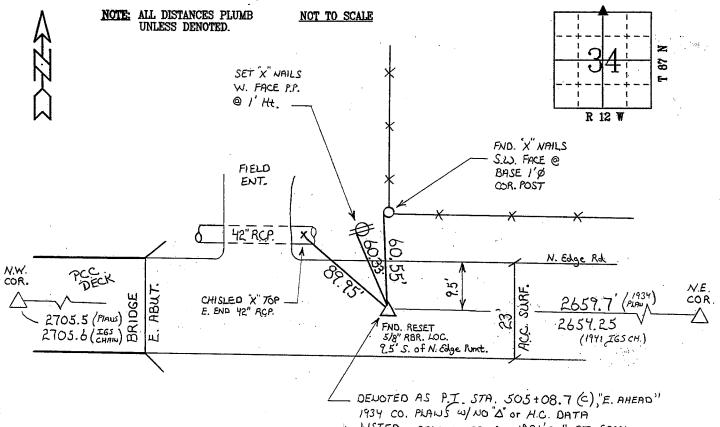

LISTED. CALCULATED $\Delta = 1^{\circ}21'30''$ RT FROM 1940'S IGS RANDOM LIVE CHAIN, CO. BK 1037

NOTE: CORNER CERTIFICATE FILED TO REPLACE COUNTY PRESERVATION RECORD DATED 4/17/97

KING

3890

FIELD SURVEY: G.T. & B.S. APRIL 1997 PREPARED BY: C.W. & G.T. 12/03/98

<u>CERTIFICATION</u>

I hereby certify that this land surveying document was prepared and the related survey work was performed by me or under my direct personal supervision and that I am a duly licensed Land 5 (date

wal date is December 31

Pages or sheets covered by this seal:

This Land Corner Certificate Only

LIST CORNERS TO BE INDEXED

Section - Township - Range Corner N. 1/4 34 87 N 12 W