

SC  
INDEX  
MARGIN  
PROOF  
COMPARE

BLACK HAWK COUNTY IOWA:SS  
Filed for record Dec 7, 1998 at 13365  
4:00 P.M. and recorded in Book 332  
of MISC Page 490  
Recorder  
Fee N/C  
ENGINEER'S OFFICE

PREPARED BY: BLACK HAWK COUNTY ENGINEERS OFFICE  
316 E. FIFTH STREET, ROOM 211 WATERLOO, IOWA 50703

PH# (319) 291-2419  
FAX# (319) 291-2461  
SLSI 9-94  
CERT 12-98


UNITED STATES PUBLIC LAND SURVEY CORNER CERTIFICATE OF  
Land Survey Monuments situated in Section 34, Township 87 N,  
Range 12 W, of the Fifth Principal Meridian, BLACK HAWK County, Iowa.  
Previously recorded in Misc. Book N/A, Page N/A, in County Recorder's Office.

(Show reason for preparing this certificate, the evidence and detailed procedures used in establishing the corner positions and monumentation found or placed.)

Monument Description and Remarks: N.E. CORNER SECT. 34-87-12  
AFTER RESURF., FOUND 1/2" REBAR FLUSH W/ A.C.C. SURF. AND LOCATED 1' N.  
OF CL TAMA RD. @ INT. WITH KOBER RD. (N-S GRAVEL). REF. TIES FROM  
NOV. 1967 NOT RECOVERED DUE TO POSSIBLE R.O.W. CHANGES. HOWEVER, FIELD  
RECOVERED AND REF. 3 SETS OF REF. TIES FROM UNDETER. ORIGIN. (L.S. #6505?).  
RE-TIED FROM 1995 RESURF. PROJ. AND REF. TIE UPDATE SPRING 1997.

### PLAN - VIEW


(Show a minimum of three reference ties to durable physical objects, relevant monuments and physical conditions that will enable recovery of the corner.)

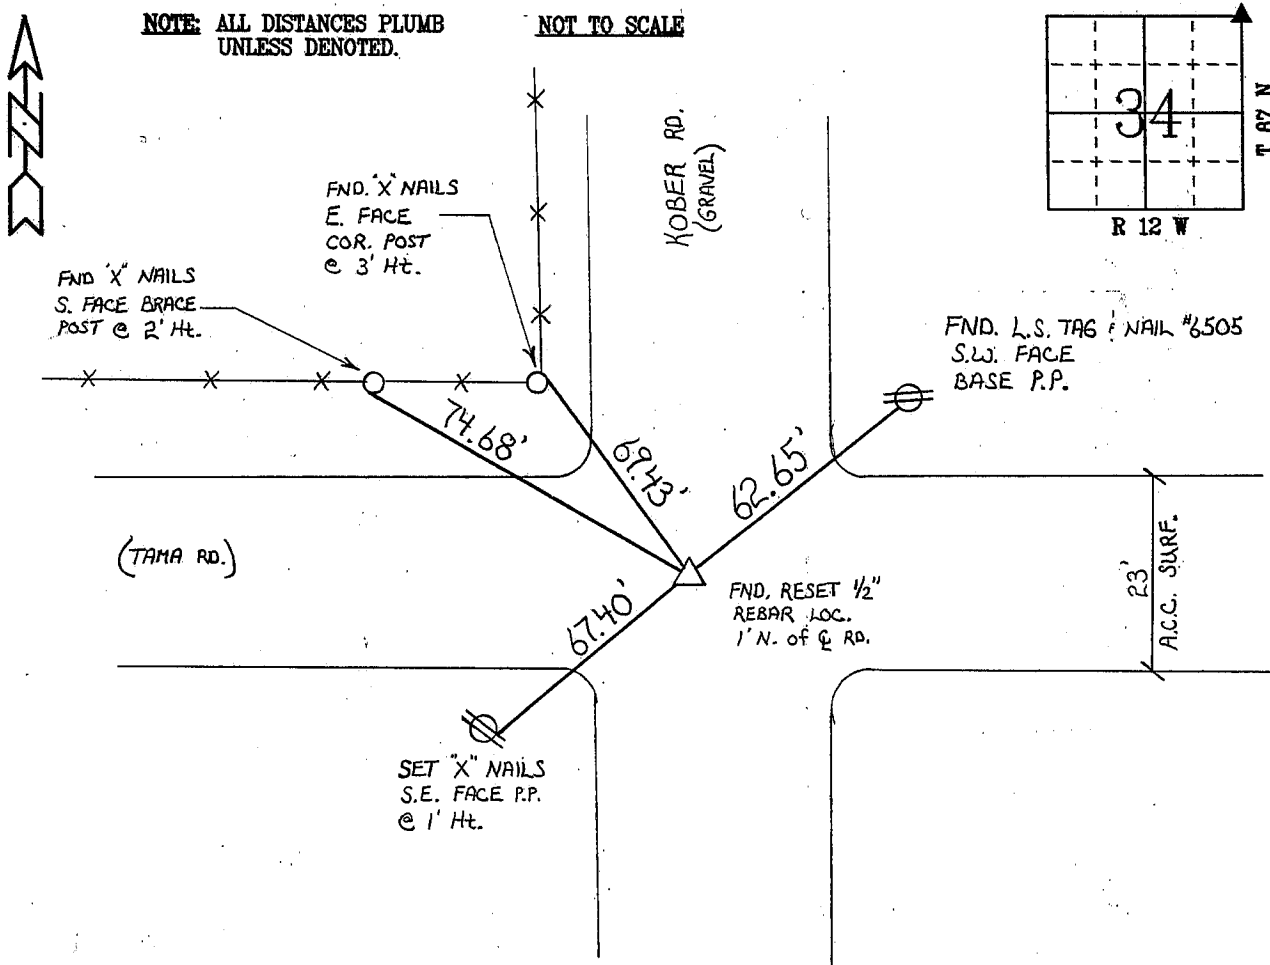

NOTE: CORNER CERTIFICATE FILED TO REPLACE COUNTY  
PRESERVATION RECORD DATED 4/17/97

FIELD SURVEY: G.T. & B.S. APRIL 1997  
PREPARED BY: C.W. & G.T. 12/02/98

### CERTIFICATION

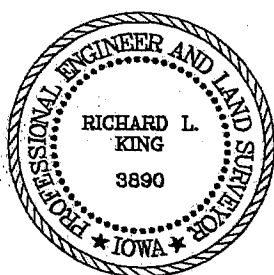

I hereby certify that this land surveying document was prepared and the related survey work was performed by me or under my direct personal supervision and that I am a duly licensed Land Surveyor under the laws of the State of Iowa.

Richard L. King 12/5/98  
Richard L. King (date)

License Number 3890

My license renewal date is December 31, 1999

Pages or sheets covered by this seal:

This Land Corner Certificate Only.

### LIST CORNERS TO BE INDEXED

Corner	Section	Township	Range
N.E.	34	87 N	12 W