PREPARED BY:

BLACK HAWK COUNTY ENGINEERS OFFICE 316 E. FIFTH STREET, ROOM 211 WATE

PH.# (319) 291-2419 FAX.# (319) 291-2461

WATERLOO, IOWA 50703

SLSI 9-94 CERT 12-96

UNITED STATES PUBLIC LAND SURVEY CORNER CERTIFICATE OF

Land Survey Monuments situated in Section___ ___, Township<u>87 N</u> Range 12 W , of the Fifth Principal Meridian, BLACK HAWK County, Iowa. Previously recorded in Misc. Book $\overline{N/A}$, Page $\overline{N/A}$, in County Recorder's Office.


(Show reason for preparing this certificate, the evidence and detailed procedures used in establishing the corner positions and monumentation found or placed.)

Monument Description and Remarks: N. 1/4 CORNER SECT. 35-87-12 AFTER RESURF, FOUND 5/8" REBAR FLUSH W/ A.C.C. SURF. AND LOCATED 13.2" N. OF S. EDGE PAVEMENT. REF. TIES FROM NOV. 1967 NOT RECOVERED HOWEVER, FIELD RECOVERED 4 SETS OF EXISTING REF. TIES AND UTILIZED. (UNKNOWN ORIGIN).

RE-TIED FROM 1995 RESURF, PROJ. AND REF. TIE UPDATE SPRING 1997.

PLAN - VIEW

(Show a minimum of three reference ties to durable physical objects, relevant monuments and physical conditions that will enable recovery of the corner.)

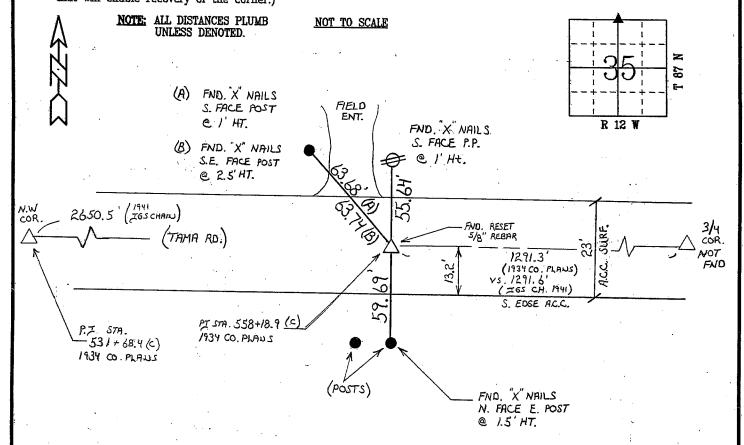

NOTE: CORNER CERTIFICATE FILED TO REPLACE COUNTY PRESERVATION RECORD DATED 4/17/97

INEER

RICHARD 1

KING

3890

* AWOL *

FIELD SURVEY APRIL 1997 PREPARED BY: C.W. & G.T. 12/02/98

<u>CERTIFICATION</u>

I hereby certify that this land surveying document was prepared and the related survey work was performed by me or under my direct personal supervision and that I am a duly licensed Land Surveyor under the laws of the State of lowa. (date)

1999 My license renewal date is December S1.

Pages or sheets covered by this seal:

This Land Corner Certificate Only

LIST CORNERS TO BE INDEXED

<u>Corner</u> Section - Township - Range N. 1/435 87 N 12 W