

HELLAND ENGINEERING & SURVEYING

Jeffrey P. Helland, 1107 Technology Parkway, Cedar Falls, Iowa 50613-6951, (319)-266-0161

UNITED STATES PUBLIC LAND SURVEY CORNER CERTIFICATE  
OF

LAND SURVEY MONUMENTS SITUATED IN SECTION NO. 36, TOWNSHIP NO. 87 NORTH, RANGE NO. 12 WEST OF THE FIFTH PRINCIPAL MERIDIAN, BLACK HAWK COUNTY, IOWA.

PREVIOUSLY RECORDED IN

(SHOW REASON FOR PREPARING THIS CERTIFICATE, THE EVIDENCE AND DETAILED PROCEDURES USED IN ESTABLISHING THE CORNER POSITIONS AND MONUMENTATION FOUND OR PLACED.)


MONUMENT DESCRIPTION AND REMARKS:

No USPLSCC on file. Survey completed in the NW 1/4 and the SW 1/4 of Sec. 36-T87N-R12W.

- CENTER: No Black Hawk County Engineer reference ties available. Auditor's Survey Book 1 Page 284 dated 7/12/1867 calls for a "Stone." Started excavation at intersection of a line between the E 1/4 Corner & NE Corner of the NW 1/4 SE 1/4 and the West line of Lot 28 in "Watson's Addition". Found three pieces of limestone (6"Ø± on average) 1.2' deep. Set No. 4 rebar w/OPC #16264 in center of three limestones which corresponds to said intersection.
- NE CORNER of SE 1/4 SW 1/4: No Black Hawk County Engineer reference ties available. Auditor's Survey Book 1 Page 284 dated 7/12/1867 calls for a "Stone." Found limestone (6"N-Sx9"E-WX12")± 2.0' deep in line w/fences (in poor repair) running East, West and South. Set No. 4 rebar w/OPC #16264 above.

PLAN VIEW

(SHOW A MINIMUM OF THREE REFERENCE TIES TO DURABLE PHYSICAL OBJECTS, RELEVANT MONUMENTS AND PHYSICAL CONDITIONS THAT WILL ENABLE RECOVERY OF THE CORNER.)

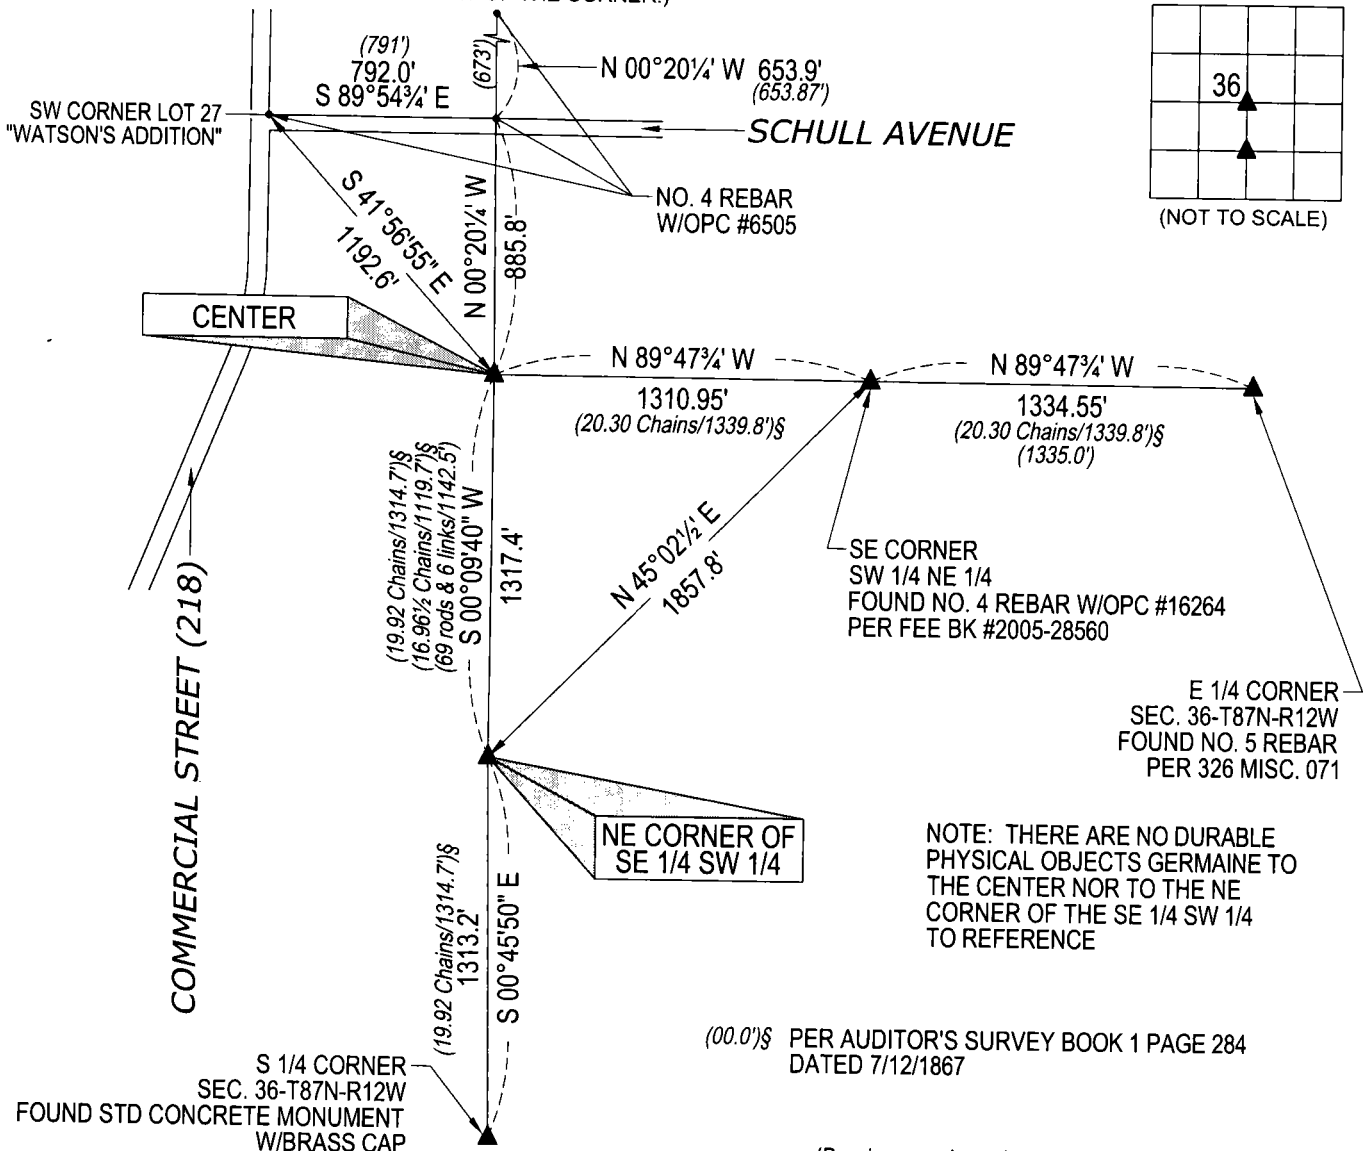

(Bearings are based upon Geodetic North)




HELLAND ENGINEERING & SURVEYING, LTD.  
1107 Technology Parkway  
Cedar Falls, Iowa 50613-6951  
(319)-266-0161

shiner = 8d nail & 1 15/16"Ø metal shiner  
OPC = Plastic cap (O=orange, R=red, Y=yellow)

(00') Recorded As

File Name: 06-131c1.dwg

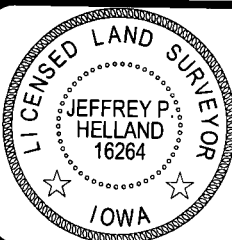

I hereby certify that this land surveying document was prepared and the related survey work was performed by me or under my direct personal supervision and that I am a duly licensed Land Surveyor under the laws of the State of Iowa.

Jeffrey P. Helland 4/4/06  
Jeffrey P. Helland  
License Number 16264  
My license renewal date is December 31, 2007.  
All pages or sheets are covered by this seal except:

LIST CORNERS TO BE INDEXED

CORNER	SECTION	TOWNSHIP	RANGE
CENTER	36	87N	12W
NE CORNER SE 1/4 SW 1/4	36	87N	12W