

PROOF sfFILED FOR RECORD JAN 23, 2004, AT 11:00 AM FEE 1-5.00-5.00

COMPARED

Patricia A. Lee

BLACK HAWK COUNTY RECORDER

ENV WAYNE CLAASSEN ENGINEERING AND SURVEYING INC PO BOX 898 WATERLOO IOWA 50704

WAYNE CLAASSEN ENGINEERING AND SURVEYING, INC.
P.O. BOX 898 WATERLOO, IOWA 50704-0898PHONE: (VOICE) 319-235-6294
(FAX) 319-235-0028

UNITED STATES PUBLIC LAND SURVEY CORNER CERTIFICATE


Land Survey Monuments situated in Section 2 Township 87N, Range 13W, of the Fifth Principal Meridian, Black Hawk County, Iowa.Previously recorded in N/A MISC. BK. 330 p. 54 (A.T.) in County Recorder's Office.
(book, page, document number, etc.)

(Show reason for preparing this certificate, the evidence and detailed procedures used in establishing the corner positions and monumentation found or placed.)

Monument Description and Remarks SW corner, found capped pin No. 3362 6" deep in gravel surface roadway - CES found a std conc. monument 13" deep in 1983, at which time the capped pin was set over the monument and an iron pin was set along side the conc monument.

PLAN - VIEW

(Show a minimum of three reference ties to durable physical objects, relevant monuments and physical conditions that will enable recovery of the corner.)

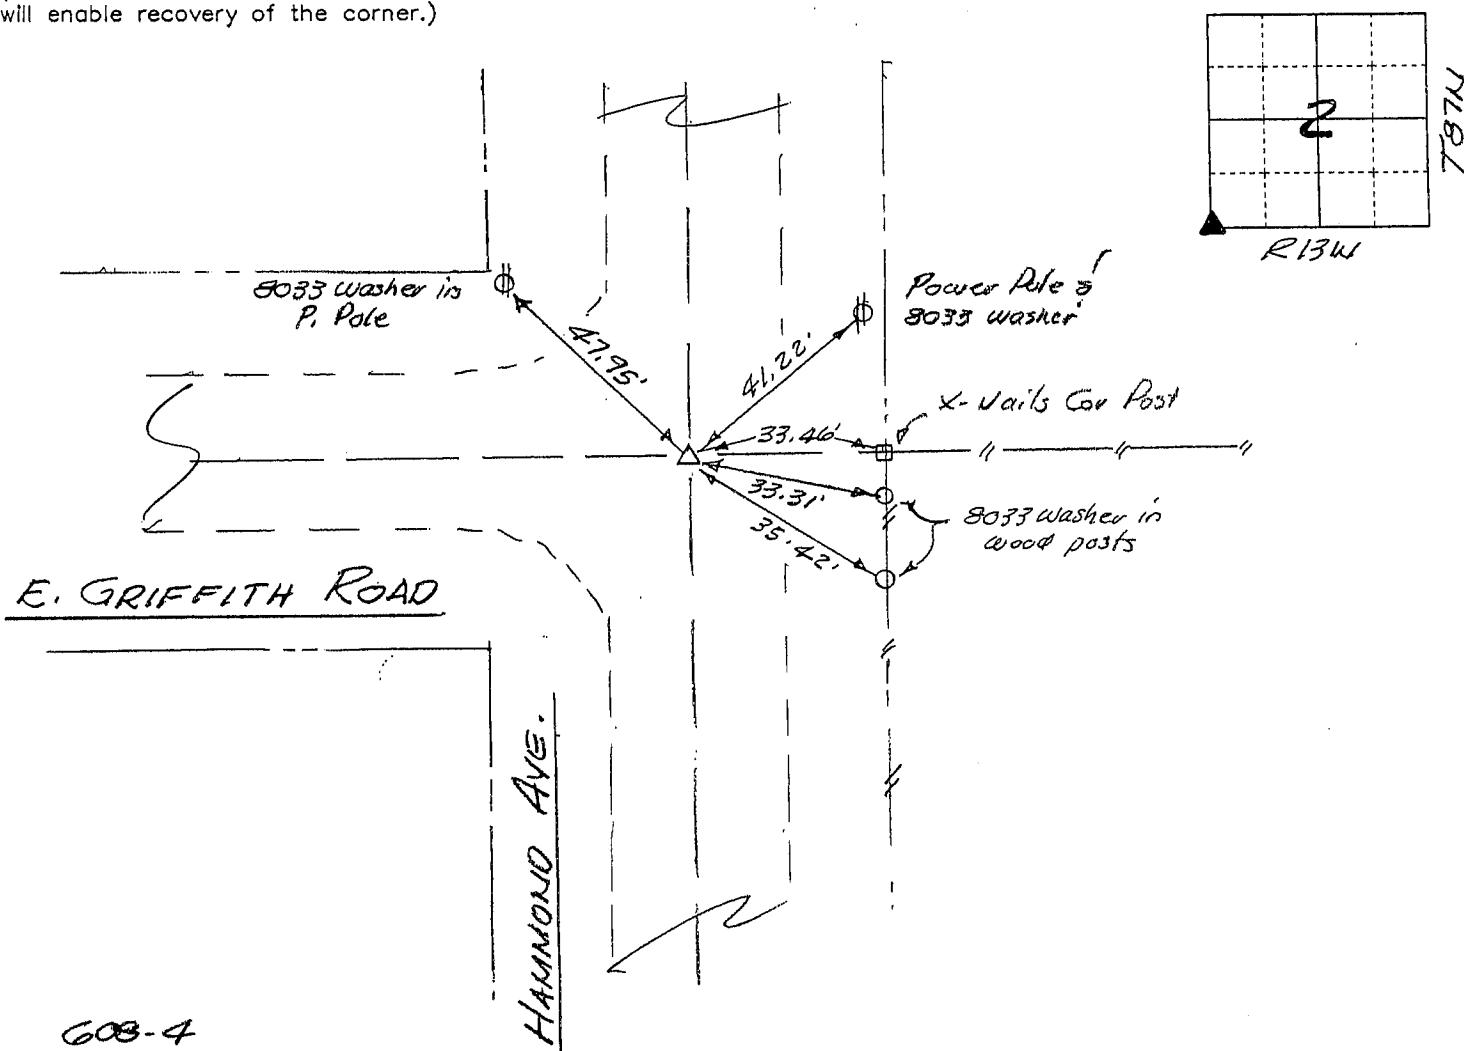

I hereby certify that the survey work was completed and this certificate was prepared by me or under my direct personal supervision and that I am a duly licensed land surveyor under the laws of the state of Iowa.

List Corners to be Indexed

Corners	Section	Twp	Range
SW	2	87N	13W

Signature: F. William King

(Name typed or printed:)

F. William KingDate: 1-22-04Lic. No. 8033

SEAL

