



Doc ID: 009700660001 Type: GEN
Recorded: 11/12/2019 at 01:04:18 PM
Fee Amt: \$7.00 Page 1 of 1
Black Hawk County Iowa
SANDIE L. SMITH RECORDER

File **2020-00008748**

PREPARED BY / RETURN TO: MIRANDA K. EILDERS IOWA DEPARTMENT OF TRANSPORTATION 428 43rd ST. SW MASON CITY, IA 50401 641-423-7584

UNITED STATES PUBLIC LAND SURVEY CORNER CERTIFICATE
OF

Land Survey Monuments situated in Section 34, Township 87N, Range 13W
of the Fifth Principal Meridian, BLACK HAWK County, Iowa.

Previously recorded in BOOK 756 PAGE 294 in County Recorder's Office.
(book, page, document number, etc.)

(Show reason for preparing this certificate, the evidence and detailed procedures used in establishing the corner positions and monumentation found or placed.)

Monument Description and Remarks: N 1/4 CORNER REPLACED PREVIOUSLY FOUND HINGE NAIL WITH
MAG SPIKE/IDOT SEC. COR. WASHER *22293 4.5' WEST OF ACC C IA 21 PER PREVIOUS CERT OF RECORD BOOK 756
PAGE 294 AFTER RESURFACING PROJECT STP-021-5(13)--2C-86.



REASON FOR CERT: MONUMENTATION AND TIES HAVE CHANGED.

PLAN - VIEW

(Show a minimum of three reference ties to durable physical objects, relevant monuments and physical conditions that will enable recovery of the corner.)

N 1/4 CORNER

(recorded distance)

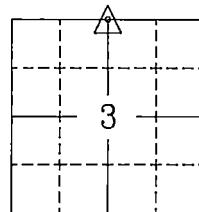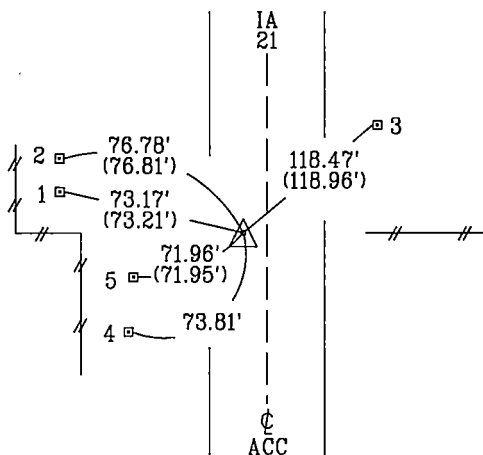

N

- △ - MAG SPIKE/IDOT SEC. COR. WASHER *22293
1 - FOUND CONCRETE MONUMENT
2 - FOUND CONCRETE MONUMENT
3 - FOUND CONCRETE MONUMENT (LEANING WEST)
4 - FOUND CONCRETE MONUMENT
5 - FOUND CONCRETE MONUMENT



I hereby certify that this land surveying document was prepared and the related survey work was performed by me or under my personal supervision and that I am duly licensed professional Land Surveyor under the laws of the state of Iowa.

Muanda K. E. Bles 11-17-2019

Miranda K. Eilders
License number 22293

My License renewal date is December 31, 2019
Pages or sheets covered by this seal. 1

List Corners to be Indexed

Corner	Section	Township	Range
--------	---------	----------	-------

S 1/4 CORNER 34 87N 13W

95-3-86-13

drawn by: TM

© 2000 by: TM, ME

File Number: 2020-00008748 Seq: 1

2 17.00 gp

171

;