Engineer

(IA.) PUBLIC LAND SURVEY U.S. CORNER CERTIFICATE (Ia. 355.11)

B.H. Co. PROJECT: FM-C007(139)--55-07 KIMBALL AVE. (V27) RESURFACING PROJECT (2016)

COLD IN-PLACE RECYCLING w/H.M.A. RESURFACING

INDEX OF ABBREVIATIONS

Doc ID: 007214890001 Type: GEN Recorded: 11/21/2016 at 12:37:56 PM Fee Amt: \$0.00 Page 1 of 1 Black Hawk County Iowa SANDIE L. SMITH RECORDER

File 2017-00009747


Land Survey Monument(s) situated in Section 04, Township 87 N., Range 13 W., the Fifth Principal Meridian (5th P.M.), BLACK HAWK County, Iowa.
Previously recorded in MISC. Book 323, Page 568, in County Recorder's Office. Township 87 N., Range 13 W., of

(Show reason for preparing this certificate): The corner monument has been Replaced or Modified, per Ia. Code 355.11(1)(c)

(Evidence and detailed procedures used in establishing the corner position(s) and monumentation found or placed.)

Monument Description and Remarks: N.E. COR.:

CORNER RESET & TIES UPDATED PER COLD-IN-PLACE RECYCLING & H.M.A. RESURF, PROJECT M-C007(139)--55-07, PRIOR TO RESURF, PROJECT, FOUND 3/4" RBR, PER CURRENT COR. CERT. TEMP. REF. COR. LOC. PER RTK GPS. AFTER 3" DP. MILL (RECYCLE), NO SOUNDING REMAINED ±RTK REFERENCE LOCATION w/ NO FURTHER EXCAVATION. PVMT. RESURFACED w/ +3" (1.5" FM-C007(139)--55-07. <u>Int. & 1.5" Surf.> H.M.A. Paving. After H.M.A. resurface, reset corner with 6"l. mag</u> spike w/ mtl. washer (pls #15748) @ ±7.0' east of c.L. H.M.A. Joint with reverse horiz. CURVES, & ALIGNED WITH DATED PCC COR. POST TO WEST, & ALSO BOUNDRY MARKERS TO EAST.

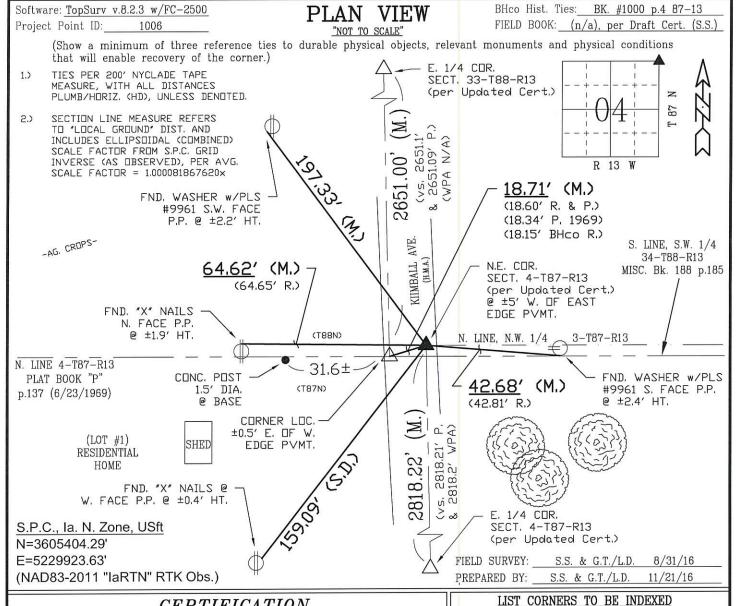

CERTIFICATION

I hereby certify that this land surveying document was prepared and the related survey work was performed by me or under my direct personal supervision and that I am a duly licensed Land Surveyor under the laws of the State of Iowa.

D LAND SUP

GEOFFRY

ALLEN

TINKER

15748

* IOWA *

11/21/2016 Weoffry Con Tinker

15748 License Number_

My license renewal date is December 31, 2016

Pages or sheets covered by this seal:

This Land Corner Certificate Only



Corner

N.E. Cor.

N.W. Cor.

Range Section -Township 87 N. 13 W. 4 13 W. 87 N. 3

> PREPARED BY: BLACK HAWK COUNTY ENGINEER'S DEPT. 316 E. FIFTH ST., RM 211 WATERLOO, IA. 50703 PH. 319-833-3008 FAX. 319-833-3139 surveyor@co.black-hawk.ia.us