Doc ID: 005055290001 Type: GEN Kind: CORNER Recorded: 02/05/2013 at 10:28:35 AM Fee Amt: \$7.00 Page 1 of 1 Black Hawk County Iowa JUDITH A MCCARTHY RECORDER

File 2013-00016377

Prepared by: SCHNEIDER Land Surveying and Planning, Inc. P.O. Box 128 Farley, Iowa 52046 563-744-3631

UNITED STATES PUBLIC LAND SURVEY CORNER CERTIFICATE OF

Land Survey Monuments situated in Section 7, Township 87 North, Range 13 West of the Fifth Principal Meridian, Black Hawk County, Iowa.

Previously recorded (NONE OF RECORD)

(BOOK, PABE / INST. NO. / CABINET, SLIDE)


Monument Description and Remarks: <u>A 1/2" REBAR W/ ORANGE CAP #6505 WAS FOUND AT THE W1/4 CORNER OF SECTION 7, T87N, R13W AS ILLUSTRATED ON A PLAT OF SURVEY RECORDED IN BOOK 285, PAGE 693.</u>


A STANDARD CONCRETE MONUMENT WAS FOUND AT THE E1/4 CORNER OF SECTION 7, T87N, R13W AS ILLUSTRATED IN THE

W.P.A. NOTES DATED OCTOBER 13, 1941.

PLAN - VIEW

W1/4 CORNER SEC.7, T87N, R13W FOUND 1/2" REBAR W/ ORANGE CAP #6505

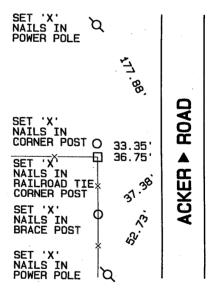

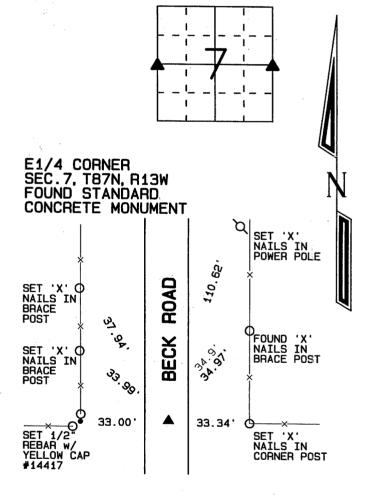

I hereby certify that this land surveying document was prepared and the related survey work was performed by me or under my direct personal supervision and that I am a duly licensed Land Surveyor under the laws of the State of Iowa.

David P. Schneider P.L.S. #14417 Date: My license renewal date is December 31, 2013.

Pages or sheets covered by this seal: THIS SHEET ONLY

SCHNEIDER

Land Surveying & Planning, Inc.

P.O. Box 128 Farley, Iowa 52046 Ph. #563-744-3631 Fax#563-744-3629



2013

List	Corners	to be	Indexed	
Corners	Section	Tw	p Range	
W1/4 CORNER	7	87	7N 13W	
E1/4 CORNER	7	87	7N 13W	