

12
P
Z

Document Number: 2007026198
Date: Jun 08, 2007 4:30:00 pm
Aud Fee: 0.00 Rec Fee: 0.00
Trans Tax: 0.00 Rec Management Fee: 0.00
E-Com Fee: 0.00 Non-Standard Page Fee: 0.00
Filed for record in Black Hawk County, Iowa
Judith A. McCarthy, County Recorder

PREPARED BY: BLACK HAWK COUNTY ENGINEERS OFFICE PH.# (319) 833-3008 SLSI 9-94
316 E. FIFTH STREET, ROOM 211 WATERLOO, IOWA 50703 FAX.# (319) 833-3139 CERT 12-96


UNITED STATES PUBLIC LAND SURVEY CORNER CERTIFICATE OF
Land Survey Monuments situated in Section 08, Township 87 N,
Range 13 W, of the Fifth Principal Meridian, BLACK HAWK County, Iowa.
Previously recorded in Misc. Book N/A, Page N/A, in County Recorder's Office.

(Show reason for preparing this certificate, the evidence and detailed procedures used in establishing the corner positions and monumentation found or placed.)

Monument Description and Remarks: E. 1/4 CORNER SECTION 08-87-13
FND. STD. WPA C.M. LOC. 10" DEEP w/ TOP BROKE, REMAINING STABLE & TRUE.
SET #5 RBR. x 0.8' L. w/ 2" ALUM. CAP @ 2" BELOW RD. SURFACE ABOVE
CENTER OF BROKE C.M., IN ADDITION TO #5 RBR. X 32" L ALONG N. FACE OF
C.M., JUST BELOW BREAK. CORNER RECOVERED FOR SECTION LINE & R.O.W.
NEEDS FOR PROPOSED BR. REPLACEMENT SOUTH. NO WPA RECORD MEASURE.
RECOVERED BY PROPORTION OF "1910 BARBER" SURVEY OF S.E. 1/4 SECT.,
AND REMAINING BH. CO. TIE TO S.E. @ S. END CMP OF F.E., DTD. 6-5-1944.

PLAN - VIEW

(Show a minimum of three reference ties to durable physical objects, relevant monuments, and physical conditions that will enable recovery of the corner.)

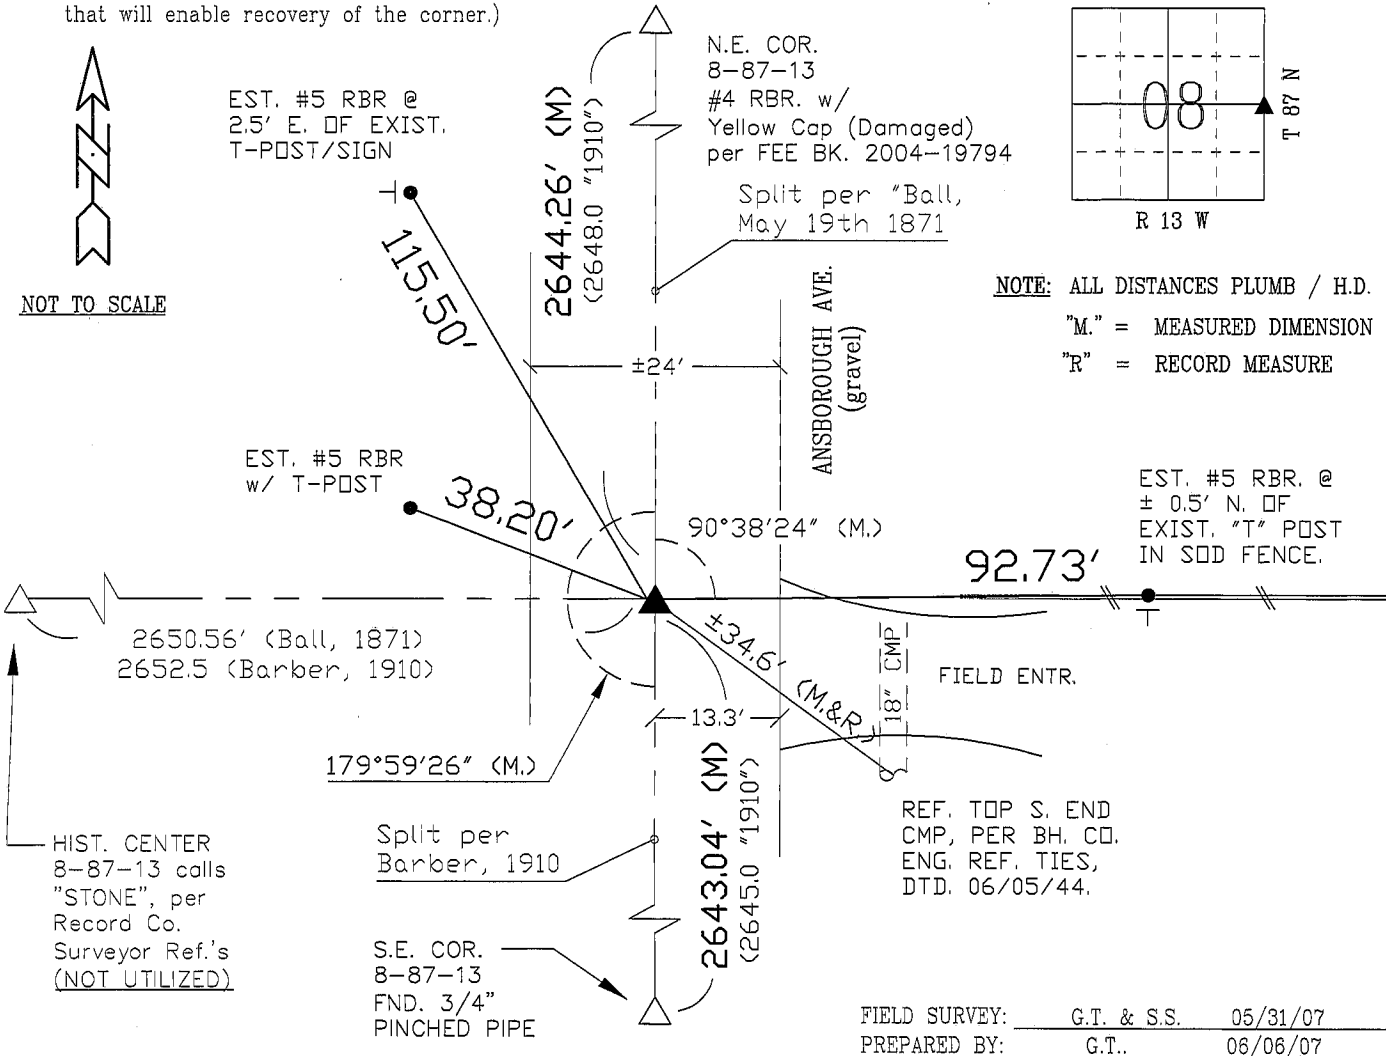

CERTIFICATION



I hereby certify that this land surveying document was prepared and the related survey work was performed by me or under my direct personal supervision and that I am a duly licensed Land Surveyor under the laws of the State of Iowa.
Geoffry Allen Tinker 06/06/07 (date)
License Number 15748
My license renewal date is December 31, 2008
Pages or sheets covered by this seal:
This Land Corner Certificate Only.

LIST CORNERS TO BE INDEXED

Corner	Section	Township	Range
E 1/4	08	87 N	13 W
W 1/4	09	87 N	13 W