

Doc ID: 005634310001 Type: GEN Recorded: 12/05/2014 at 12:00:52 PM Fee Amt: \$7.00 Page 1 of 1 Black Hawk County Iowa JUDITH A MCCARTHY RECORDER

File 2015-00009461

Prepared by & Return to: Herold - Reicks Surveying, 10 East Main Street, New Hampton, IA 50659, Ph. 641-394-2725

UNITED STATES PUBLIC LAND SURVEY CORNER CERTIFICATE

Land Survey Monuments situated in Section **13**, Township **87** North, Range **13** West of the Fifth Principal Meridian, **Black Hawk** County, Iowa. **1.)** Previously recorded in Doc. #2006-27377 in the County Recorder's office. **2.)** Previously recorded in Doc. #2007-027188 in the County Recorder's office.

This certificate is being prepared in compliance with Iowa Code Chapter 355.11 because:

☐ There is no certificate on file for this corner.
☐ There are no longer three valid ties of record.

1 & 2 ☒ There are changes to reference ties of record.


1 & 2 ☒ There is change of monumentation of record.
☐ To clarify description of record monument (ties).

Monument Description and Remarks:

- 1.) East 1/4 Corner: Set 1"Ø Bronze Survey Marker PLS 19211 at previous location (Found 5/8"Ø Rebar) by means of coordinates obtained prior to highway reconstruction, Project No. FM-TSF-C007(130)--5B-07.
- **2.) Southeast Corner:** Set 1"Ø Bronze Survey Marker PLS 19211 at previous location (Found 5/8"Ø Rebar) by means of coordinates obtained prior to highway reconstruction, Project No. FM-TSF-C007(130)--5B-07.

PLAN - VIEW

(Show a minimum of three reference ties to durable physical objects, relevant monuments and physical conditions that will enable recovery of the corner.)

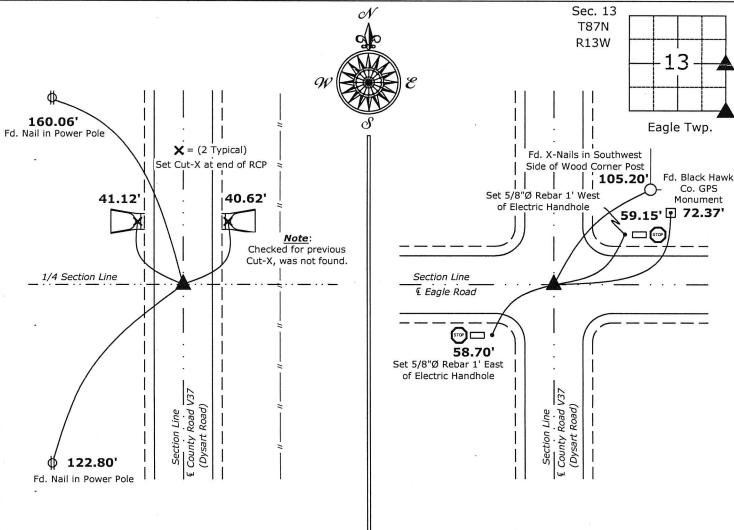

1.) East 1/4 Corner Section 13-87-13 Set 1"Ø Bronze Survey Marker PLS 19211 2.) Southeast Corner Section 13-87-13 Set 1"Ø Bronze Survey Marker PLS 19211



I hereby certify that this land surveying document was prepared and the related survey work was performed by me or under my direct personal supervision and that I am a duly licensed Land Surveyor under the laws of the State of Iowa.

Kirk D. Reicks

License number 19211

My license renewal date is December 31, 2014. Sheets covered by this seal: Individual sheet only

List Corners to be Indexed			
Corners	Section	Twp.	Range
E 1/4	13	87	13
SE	13	87	13

Project Number: 2014-135 FB: Black Hawk County 1, Pg. 17 File: S:_C3D Projects\2014\2014-135 (BH Co-Dysart)\2014-135.dwg, 12/4/2014 3:15:13 PM