



SLSI 9-90

Monument Description and Remarks: FOUND 1"Ø REBAR FLUSH WITH SURFACE OF ASPHALT PAVING, PER COUNTY TIES. NW CORNER

PLAN - VIEW
(Show a minimum of three reference ties to durable physical objects, relevant monuments and physical conditions that will enable recovery of the corner.)
"X" NAILS P. POLE

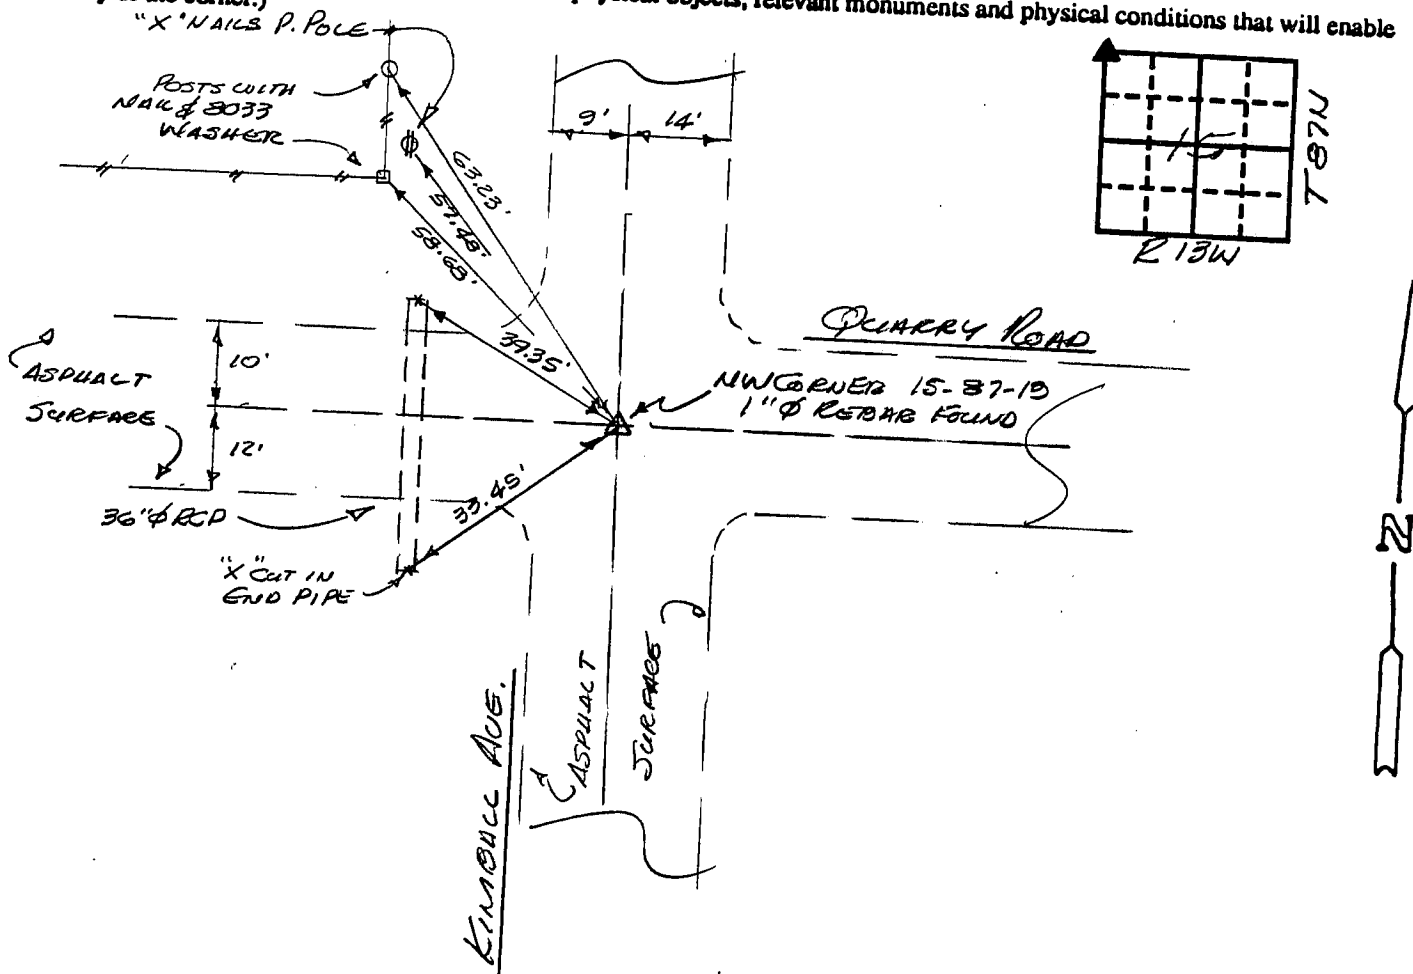

Corners	List Corners to be Indexed Section	TwP	Range
NW	15	87N	13W

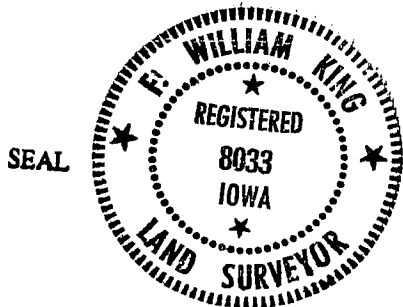

MISC. BK 295 P. 276