


# UNITED STATES PUBLIC LAND SURVEY CORNER CERTIFICATE

RECORDED

CORNER IDENTITY: E $\frac{1}{4}$  Corner Section 17-87-13

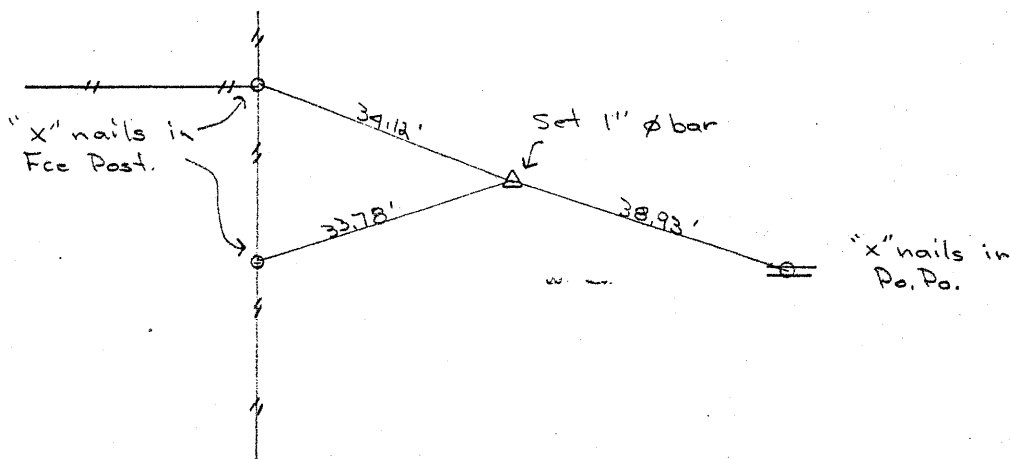

## REFERENCE TIES

DATE SURVEYED: 1-4-93

DATE DRAWN: 1-6-93

REASON FOR PREPARING CERTIFICATE: Found no evidence of the corner. Reset using old ties and retied corner out.

PROCEDURE USED AND  
CORNER DESCRIPTION: Found no monument/bar reset using old ties and split the difference. Retied using old "X" nails found.


## CERTIFICATE

I hereby certify that this plat, map, survey or report was made by me or under my direct personal supervision and that I am a duly Registered Land Surveyor under the laws of the State of Iowa.

My registration expires December 31, 1994.

1/11/93  
Date

F. R. Debe  
F. R. Debe  
Ia. Reg. No. 7811

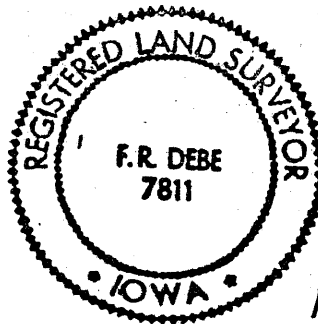

PREPARED BY  
SCHENK ENGINEERING COMPANY  
WATERLOO, IOWA

MISC. BK. 304 p. 605