


# UNITED STATES PUBLIC LAND SURVEY CORNER CERTIFICATE

RECORDED

## CORNER IDENTITY:

SE Corner Section 17-87-13

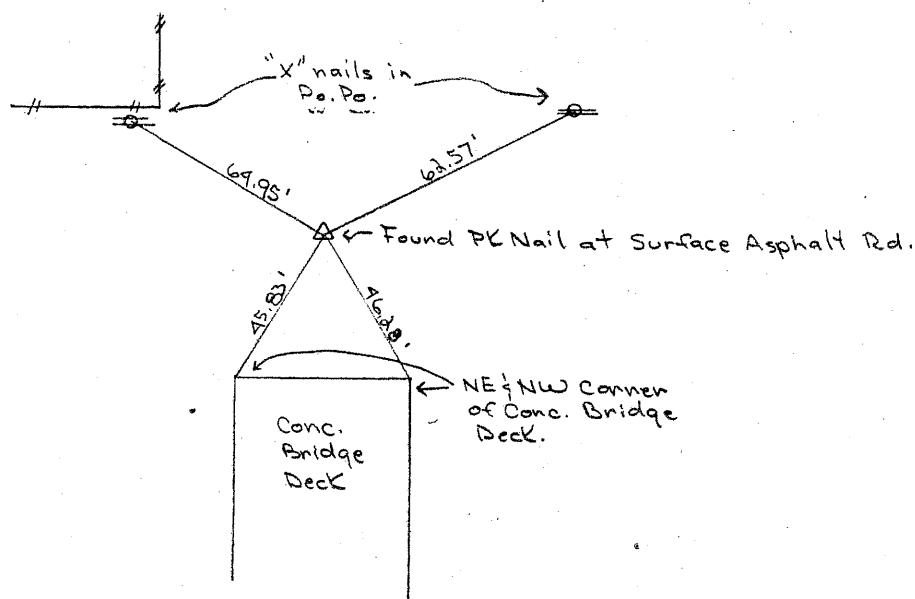

## REFERENCE TIES

DATE SURVEYED: 1-4-93

DATE DRAWN: 1-6-93

REASON FOR PREPARING CERTIFICATE: No certificate on file.

PROCEDURE USED AND  
CORNER DESCRIPTION: Found PK Nail at surface of asphalt road.


## CERTIFICATE

I hereby certify that this plat, map, survey or report was made by me or under my direct personal supervision and that I am a duly Registered Land Surveyor under the laws of the State of Iowa.

My registration expires December 31, 1994.

1/11/93  
Date

F. R. Debe  
F. R. Debe  
Ia. Reg. No. 7811

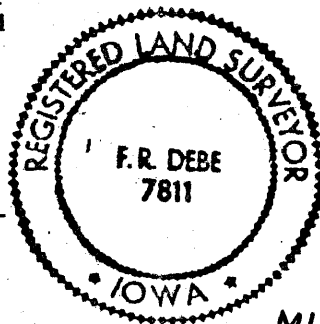

PREPARED BY  
SCHENK ENGINEERING COMPANY  
WATERLOO, IOWA

MISC. BK. 304 p. 606