




RECORDED

UNITED STATES PUBLIC LAND SURVEY CORNER CERTIFICATE

CORNER IDENTITY: SE Corner Section 18-87-13

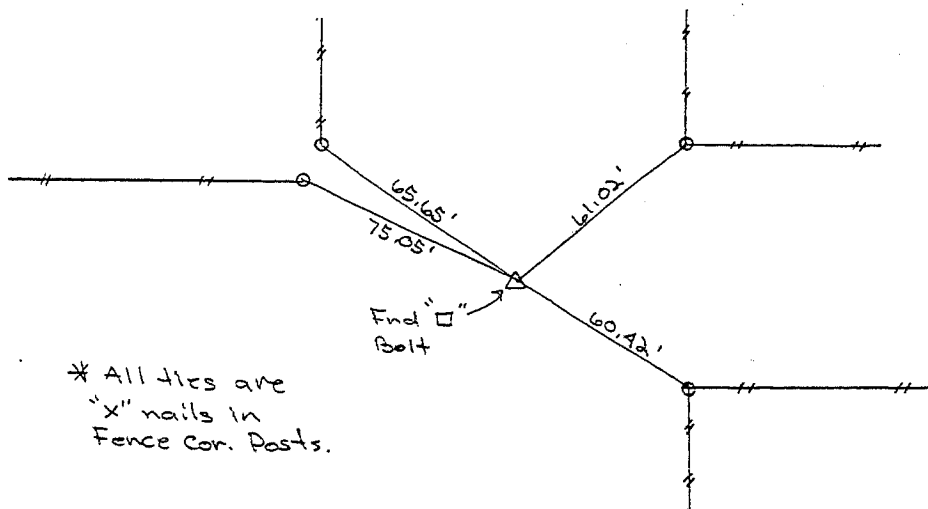

REFERENCE TIES

DATE SURVEYED: 1-4-93

DATE DRAWN: 1-6-93

REASON FOR PREPARING CERTIFICATE: No certificate on file.

PROCEDURE USED AND
CORNER DESCRIPTION: Found "□" bolt at surface of asphalt road.


CERTIFICATE

I hereby certify that this plat, map, survey or report was made by me or under my direct personal supervision and that I am a duly Registered Land Surveyor under the laws of the State of Iowa.

My registration expires December 31, 1994.

1/11/93
Date

F. R. Debe
Ia. Reg. No. 7811

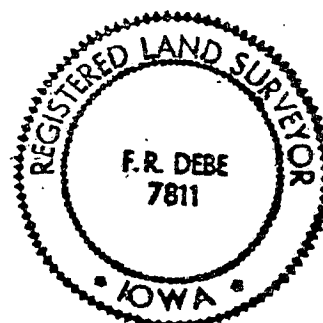

PREPARED BY
SCHENK ENGINEERING COMPANY
WATERLOO, IOWA MISC. BK. 304 p. 604