

6023

PAUL H. HELLAND, P.E. & R.L.S. IOWA REGISTRATION NO. 6505
 My registration expires December 31, 1997
 I hereby certify that this plat, map, survey or report was made by me or under my direct personal supervision and that I am a duly registered land surveyor under the laws of the State of Iowa.
 Date Oct 22, 1996
 of 115c recorded in Book 322
 of 115c Page 594
Paul H. Helland Recorder
 Fee 1-5.00x

County Assessor

PAUL H. HELLAND, 2322 W. 1ST ST., SUITE B, CEDAR FALLS, IOWA 50613, (319)-266-0161

UNITED STATES PUBLIC LAND SURVEY CORNER CERTIFICATE OF

Land Survey Monuments situated in Section 20, Township 87, Range 13, of the Fifth Principal Meridian, Black Hawk County, Iowa.
 Previously recorded in Book _____, Page _____.



(Show reason for preparing this certificate, the evidence and detailed procedures used in establishing the corner positions and monumentation found or placed.)

Monument Description and Remarks: Survey done in NW 1/4 Sec. 21-87-13

E 1/4 (or Sec. 20) -- Found Broken off concrete monument w/ 1/2" hole drilled in top center, set 1/2" rebar @ North side for magnetic pickup.

PLAN - VIEW

(Show a minimum of three reference ties to durable physical objects, relevant monuments and physical conditions that will enable recovery of the corner.)

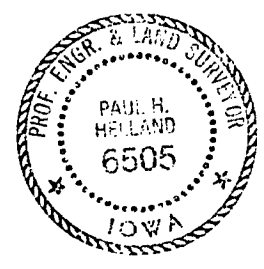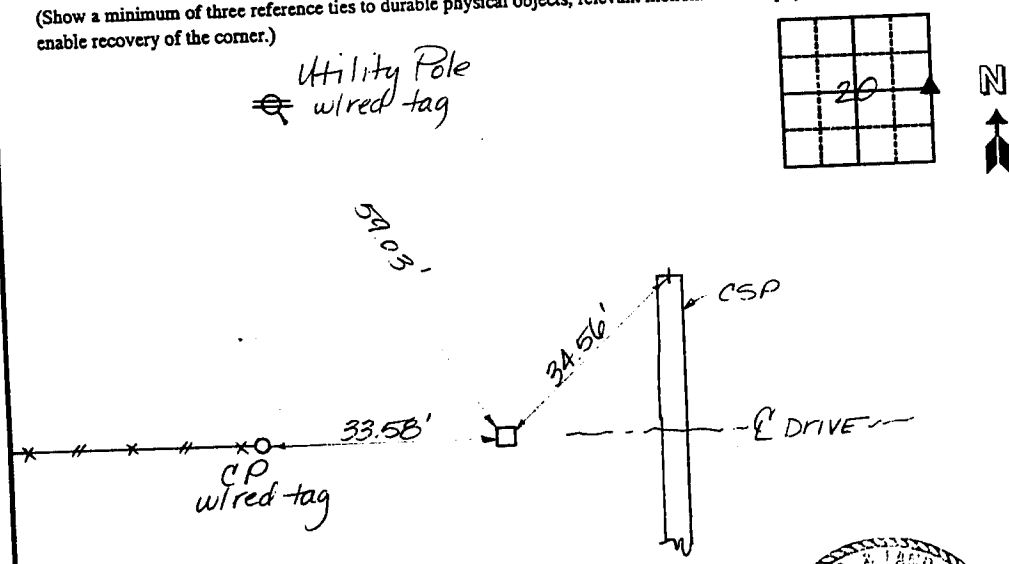

I HEREBY CERTIFY THAT THIS PLAT, MAP, SURVEY OR REPORT WAS MADE BY ME OR UNDER MY DIRECT PERSONAL SUPERVISION AND THAT I AM A DULY REGISTERED LAND SURVEYOR UNDER THE LAWS OF THE STATE OF IOWA.
Paul H. Helland DATE 10/22/96
 PAUL H. HELLAND, P.E. & R.L.S. IOWA REGISTRATION NO. 6505
 MY REGISTRATION EXPIRES DECEMBER 31, 1997
HES
 HELLAND ENGINEERING & SURVEYING, LTD.
 THUNDER RIDGE BANK BUILDING
 2322 WEST 1ST ST., SUITE B
 CEDAR FALLS, IOWA 50613
 319-266-0161

List Corners to be Indexed			
Corners	Section	Twp	Range
E 1/4	20	87	13

BOOK **322** PAGE **594**

PAUL H. HELLAND, P.E. & R.L.S. IOWA REGISTRATION NO. 6505
 MY REGISTRATION EXPIRES DECEMBER 31, 1997
HES
 HELLAND ENGINEERING & SURVEYING, LTD.
 THUNDER RIDGE BANK BUILDING
 2322 WEST 1ST ST., SUITE B
 CEDAR FALLS, IOWA 50613
 319-266-0161

E 1/4 20 87 13