

004990050001 Type: GEN ID: 004 : CORNER Ring: CURNEH Recorded: 12/04/2012 at 02:55:39 PM Fee Amt: \$0.00 Page 1 of 1 Black Hawk County Iowa JUDITH A MCCARTHY RECORDER

File 2013-00011414

PREPARED BY: * BLACK HAWK COUNTY ENGINEERS OFFICE

316 E. FIFTH STREET, ROOM 211 WATERLOO, IOWA 50703 PH.# (319) 833-3008 FAX.# (319) 833-3139

SLSI 9-94 BHCO 03-09

UNITED STATES PUBLIC LAND SURVEY CORNER CERTIFICATE OF

Land Survey Monuments situated in Section_ _, Township<u>87 N</u> 20 Range 13 W, of the Fifth Principal Meridian, BLACK HAWK County, Iowa.


Previously recorded in Misc Book 312, Page 513, in County Recorder's Office.

(Show reason for preparing this certificate): The corner monument has been Replaced or Modified, per Ia. Code 355.11(1)(c)

(Evidence and detailed procedures used in establishing the corner position(s) and monumentation found or placed.)

Monument Description and Remarks: N. 1/4 CORNER:

CORNER RESET FOR COLD-IN-PLACE RECYCLE & H.M.A. RESURF, PROJECT LFM-503--7X-07.
PRIOR TO RESURF, PROJECT, FOUND #5 (5/8") REBAR PER CURRENT RECORD AND TEMP, REF.
CORNER LOCATION PER RTK GPS. AFTER 4" DEEP MILL & RECYCLE COURSE, FAINT SOUNDING REMAINED AND EXCAVATED TO -0.55' DEEP w/o FURTHER CORNER RECOVERY LOCATION. AFTER +3'' H.M.A. RESURF, COURSE, RESET CORNER WITH 5/8'' (#5) \times $\pm8''$ L REBAR LOCATED @ ±0.6' SOUTH OF H.M.A. JOINT AND ±ALIGNED WITH EXISTING FENCE LINE TO SOUTH.

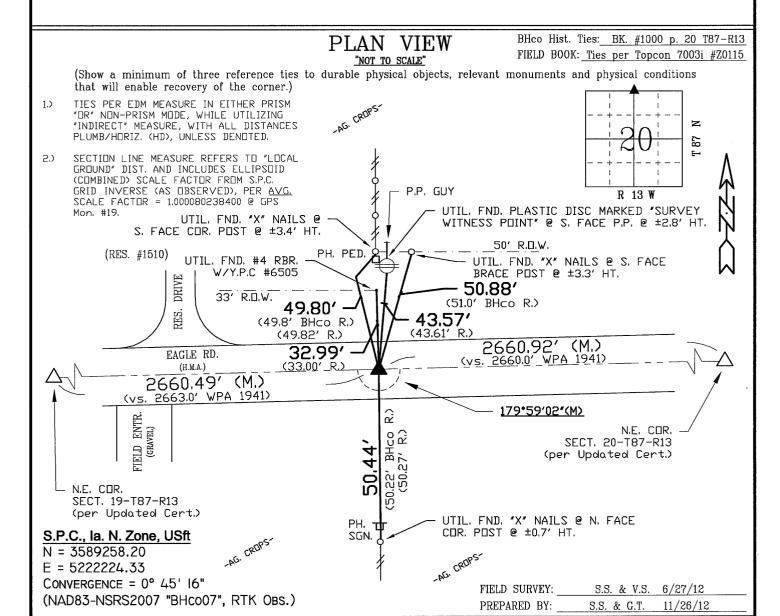

<u>CERTIFICATION</u>



I hereby certify that this land surveying document was prepared and the related survey work was performed by me or under my direct personal supervision and that I am a duly licensed Land Surveyor under the laws of the State of Iowa.

15748

2012 My license renewal date is December 31,

Pages or sheets covered by this seal:

This Land Corner Certificate Only

LIST CORNERS TO BE INDEXED Section -

<u>Corner</u> Township -13 W 20 87 N N. 1/4 Cor. S. 1/4 Cor. 13 W

INDEX OF ABBREVIATIONS

"NP" = Reflectorless EDM Meas.
"MLM" = Indirect Measure
"CM" = Concrete Monument
"SM" = Survey Marker Spike/Tag
"PK" = PK/MAG Nail Brand Style "Measured" Dimension
"Platted" Dimension
"Record" Dimension
"Calculated" Dimension

= lowa Geodetic Survey "PK" = PK/MAG Nail Brat = Works Progress Admin. Survey per George Miller Survey (BHco Surveyor 1858-1860) per John Ball Survey (BHco Surveyor 1866-1891) per Nathan Barber Survey (BHco Surveyor 1908-1931

2012