

File **2013-00011416**

SLSI 9-94
BHCO 03-09

Land Survey Monuments situated in Section 21, Township 87 N,
Range 13 W, of the Fifth Principal Meridian, BLACK HAWK County, Iowa.
Previously recorded in ~~Misc~~ Book 2005, Page 10196, in County Recorder's Office.

(Evidence and detailed procedures used in establishing the corner position(s) and monumentation found or placed.)

CORNER RESET FOR COLD-IN-PLACE RECYCLE & H.M.A. RESURF. PROJECT LFM-503--7X-07.
PRIOR TO RESURF. PROJECT, FOUND #5 (5/8") REBAR PER CURRENT RECORD AND TEMP. REF.
COR. LOCATION PER RTK GPS. AFTER 4" DEEP MILL & RECYCLE COURSE, NO SOUNDING
REMAINED & NO EXCAVATION DONE @ LOCATION. AFTER +3" H.M.A. RESURF. COURSE, RESET
CORNER WITH 5/8" (#5) x ±8" L REBAR LOCATED @ ±0.3' SOUTH OF H.M.A. JOINT AND ±
ALIGNED WITH EXISTING FENCE LINE TO SOUTH.

FIELD BOOK: Ties per Topcon 7003i #Z0115


T 87 N

AG. CROPS-

(NAD83-NSRS2007 "BHco07", RTK OBS.)

PREPARED BY: S.S. & G.T. 11/26/12

<u>Corner</u>	<u>Section</u> -	<u>Township</u> -	<u>Range</u>
N. 1/4 Cor.	21	87 N	13 W
S. 1/4 Cor.	16	87 N	13 W

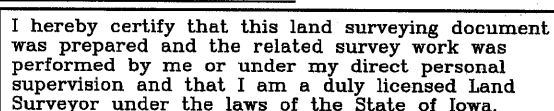

This Land Corner Certificate Only.

INDEX OF ABBREVIATIONS

(M) = "Measured" Dimension	"NP" = Reflectless EDM Meas.
(P) = "Platted" Dimension	"MLM" = Indirect Measure
(R) = "Record" Dimension	"CM" = Concrete Monument
"C" = "Calculated" Dimension	"SM" = Survey Marker Spike/Tag
"GS" = Iowa Geodetic Survey	"PK" = PK/MAG Nail Brand Style
"WPA" = Works Progress Admin. Survey	
"Φ" = per George Miller Survey (BHC Surveyor 1858-1860)	
"δ" = per John Ball Survey (BHC Surveyor 1866-1891)	
"N" = per Nathan Barber Survey (BHC Surveyor 1908-1931)	