PQ

Document Number: 2007027129

Date: Jun 20, 2007 4:30:00 pm

Aud Fee:

Rec Fee:

0.00

0.00 0.00

 $\mathbf{Z}$ 

0.00 Trans Tax: 0.00 Rec Management Fee: 0.00 Non-Standard Page Fee:


Filed for record in Black Hawk County, Iowa Judith A. McCarthy, County Recorder

PH.# (319) 833-3008 FAX.# (319) 833-3139 BLACK HAWK COUNTY ENGINEERS OFFICE PREPARED BY: SLSI 9-94 CERT 12-96 WATERLOO, IOWA 316 E. FIFTH STREET, ROOM 211

UNITED STATES, PUBLIC LAND SURVEY CORNER CERTIFICATE OF \_\_, Township<u>87 N</u> Land Survey Monuments situated in Section\_\_\_ 23 Range 13 W, of the Fifth Principal Meridian, BLACK HAWK County, Iowa. Previously recorded in Misc. Book 311, Page 988, in County Recorder's Office.

(Show reason for preparing this certificate, the evidence and detailed procedures used in establishing the corner positions and monumentation found or placed.)

Monument Description and Remarks: FND. SQUARE HEAD STEEL PIN PRIOR TO RESURF, PROJECT, CUR. REC. PER PLS #3682 STATES #6 (3/4") REBAR. CORNER TEMP, REF. AND RETIED AS DENOTED, DUE TO PLAN 51/2" HMA RESURFACING. RESET #5 REBAR x 6" L., LOCATED 0.20' S. OF C.L. ACC JOINT E/W. ONLY ONE PREVIOUS TIE FROM CURRENT RECORD REMAINS, PER BELOW, W/ PH. PED. UNSTABLE / VARIED AND WAS NOT RE-UTILIZED, WHILE CHURCH SIGN IS NEWER

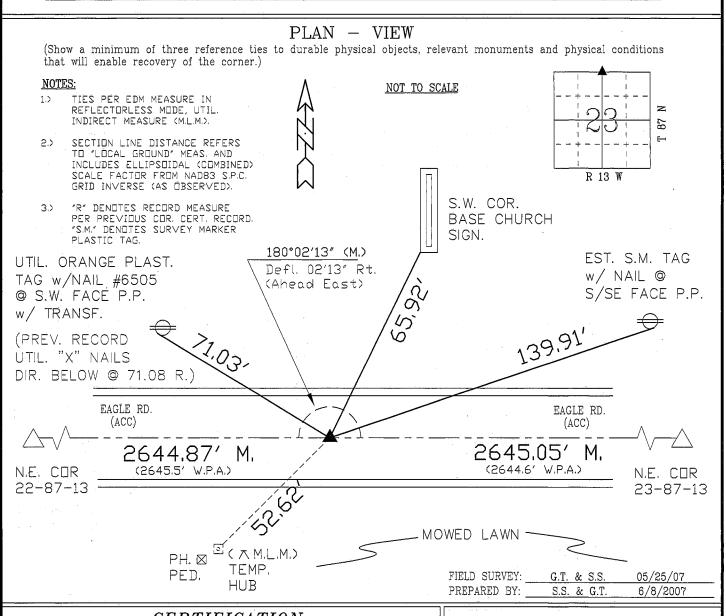

## **CERTIFICATION**



I hereby certify that this land surveying document was prepared and the related survey work was performed by me or under my direct personal supervision and that I am a duly licensed Land Surveyor under the laws of the State of Iowa.

License Number\_

2007 My license renewal date is December 31,\_

Pages or sheets covered by this seal:

This Land Corner Certificate Only

## LIST CORNERS TO BE INDEXED

Corner <u>Section</u> - <u>Township</u> - <u>Range</u> N. 1/4 COR. 23 87 N 13 W S. 1/4 COR. 87 N 14 13 W