

I  
P  
Z

Document Number: 2007027118  
Date: Jun 20, 2007 4:30:00 pm  
Aud Fee: 0.00 Rec Fee: 0.00  
Trans Tax: 0.00 Rec Management Fee: 0.00  
E-Com Fee: 0.00 Non-Standard Page Fee: 0.00  
Filed for record in Black Hawk County, Iowa  
Judith A. McCarthy, County Recorder

PREPARED BY: BLACK HAWK COUNTY ENGINEERS OFFICE PH.# (319) 833-3008 SLSI 9-94  
316 E. FIFTH STREET, ROOM 211 WATERLOO, IOWA 50703 FAX.# (319) 833-3139 CERT 12-96


UNITED STATES PUBLIC LAND SURVEY CORNER CERTIFICATE OF  
Land Survey Monuments situated in Section 24, Township 87 N, Range 13 W, of the Fifth Principal Meridian, BLACK HAWK County, Iowa. Previously recorded in Fee Book 2006, Page 27377, in County Recorder's Office.

(Show reason for preparing this certificate, the evidence and detailed procedures used in establishing the corner positions and monumentation found or placed.)


Monument Description and Remarks: FND #5 RBR. PRIOR TO RESURF. PROJECT CORNER TEMP. REF. AND RETIED AS DENOTED, DUE TO PLAN 5 1/2" HMA RESURFACING. RESET #5 REBAR x 5" L., LOCATED C.L. INTERSECTION ON C.L. ACC JOINT N/S. CURRENT TIES PER PLS. #8505 NOT UTILIZED AS FINAL TIES DUE TO POSITIONS BEING TOO LOW, YET WERE VERIFIED DURING TEMP. REFERENCES.

PLAN - VIEW

(Show a minimum of three reference ties to durable physical objects, relevant monuments and physical conditions that will enable recovery of the corner.)

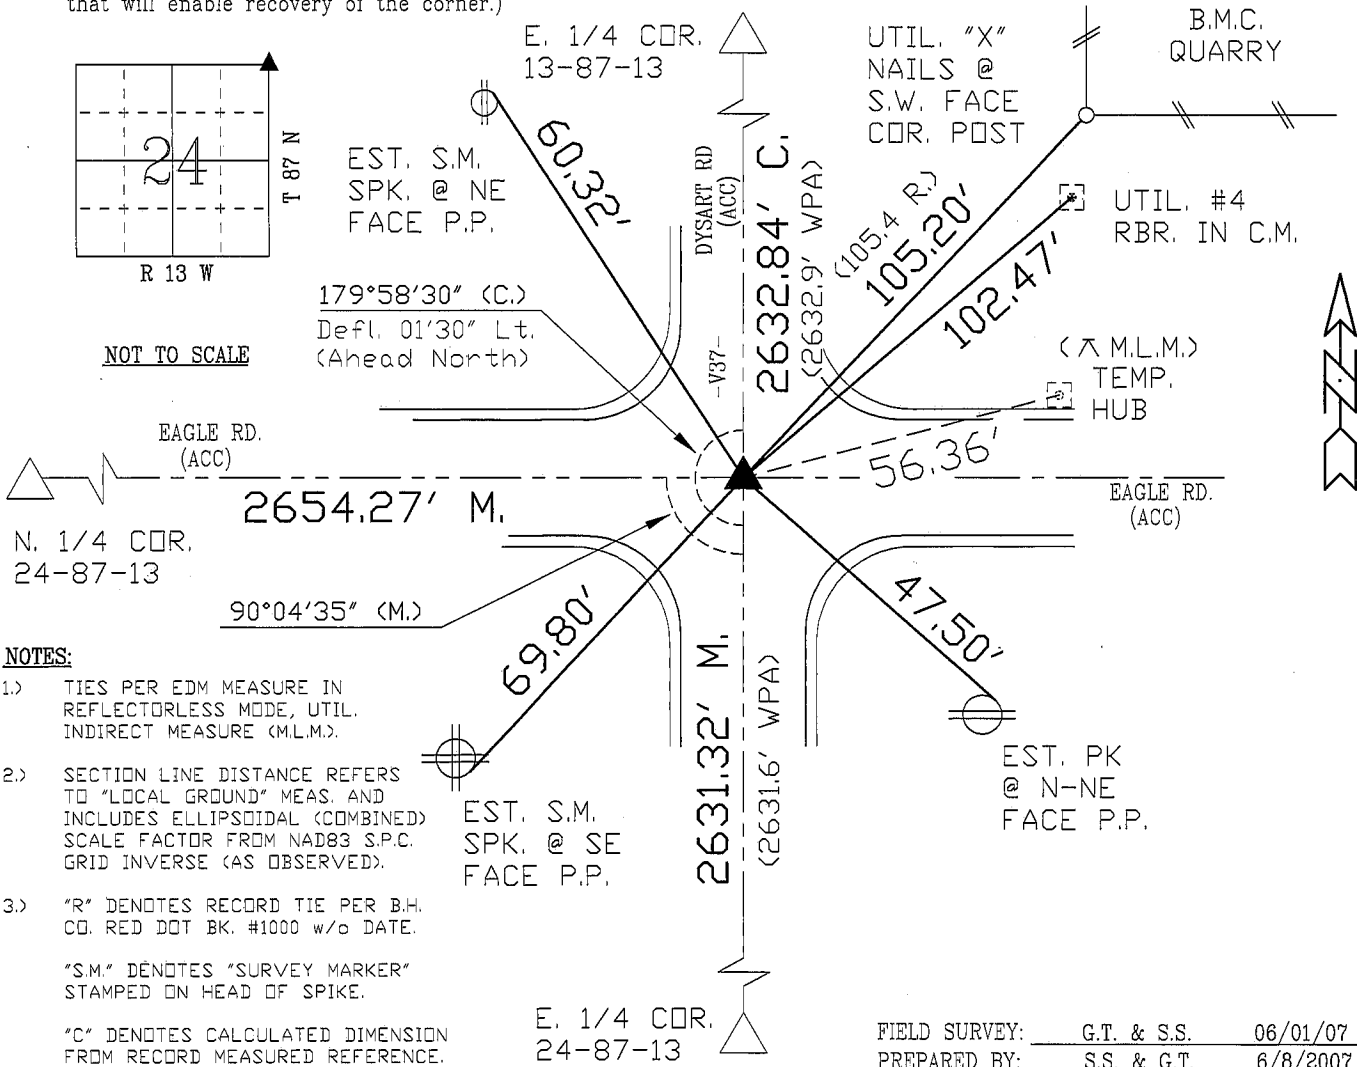

CERTIFICATION

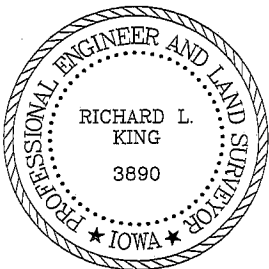

I hereby certify that this land surveying document was prepared and the related survey work was performed by me or under my direct personal supervision and that I am a duly licensed Land Surveyor under the laws of the State of Iowa.  
Richard L. King 6/9/07 (date)  
License Number 3890  
My license renewal date is December 31, 2007  
Pages or sheets covered by this seal:  
This Land Corner Certificate Only.

LIST CORNERS TO BE INDEXED

Corner	Section	Township	Range
N.E. COR.	24	87 N	13 W
S.W. COR.	18	87 N	12 W
N.W. COR.	19	87 N	12 W
S.E. COR.	13	87 N	13 W