

\* HELLAND ENGINEERING  
Jeffrey P. Helland, 1107 Technology Parkway, Cedar Falls, Iowa 50613-6951, (319)-266-0161

## UNITED STATES PUBLIC LAND SURVEY CORNER CERTIFICATE OF

LAND SURVEY MONUMENTS SITUATED IN SECTION NO. 27, TOWNSHIP NO. 87 NORTH, RANGE  
NO. 13 WEST OF THE FIFTH PRINCIPAL MERIDIAN, BLACK HAWK COUNTY, IOWA.  
PREVIOUSLY RECORDED IN N/A

(SHOW REASON FOR PREPARING THIS CERTIFICATE, THE EVIDENCE AND DETAILED PROCEDURES USED IN ESTABLISHING THE  
CORNER POSITIONS AND MONUMENTATION FOUND OR PLACED.)


### MONUMENT DESCRIPTION AND REMARKS:

NO USPLSCC ON FILE. SURVEY COMPLETED IN THE NE 1/4 OF SEC. 27-T87N-R13W.

→ **N 1/4 CORNER:** W.P.A. NOTES (UNDATED) CALLS FOR [FOUND LIMESTONE 6"x3"x3" WOOD STAKE 17"x3"x1"]. W.P.A.  
NOTES (UNDATED) CALLS FOR [AT LOCATION INDICATED BY RANDOM LINE DUG HOLE 4" SQ. 18" DEEP FOUND LIMESTONE  
6"x3"x3" WOODSTAKE 17"x3"x1" LOWERED ALL EVIDENCE IN PLACE AND SET C.M. ON TOP WITH CAP MARKED. SET TOP OF  
C.M. 12" DEEP.]. FOUND NO. 6 REBAR w/WOOD LATHE (0.8' DEEP). STRUCK C.M. BELOW SAID REBAR (3.1' DEEP). UTILIZED  
SAID REBAR AS CORNER.

### PLAN VIEW

(SHOW A MINIMUM OF THREE REFERENCE TIES TO DURABLE PHYSICAL OBJECTS, RELEVANT MONUMENTS AND PHYSICAL  
CONDITIONS THAT WILL ENABLE RECOVERY OF THE CORNER.)

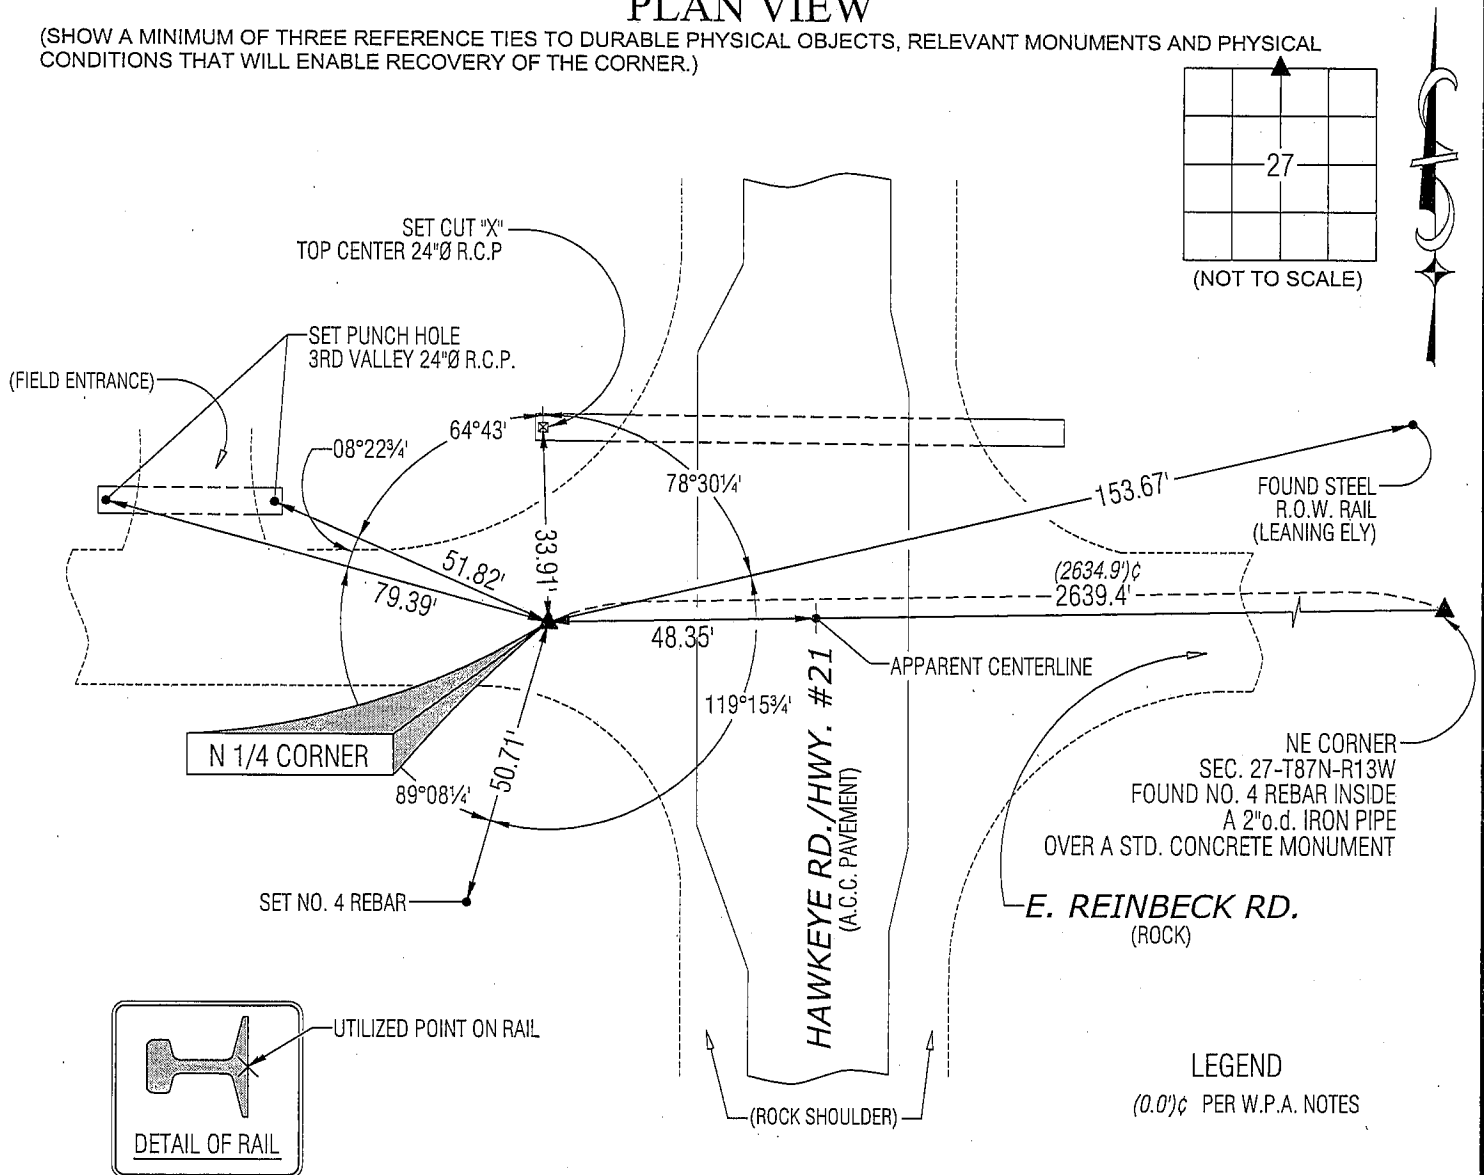


(BEARINGS ARE ASSUMED)



HELLAND ENGINEERING & SURVEYING, LTD.  
1107 Technology Parkway  
Cedar Falls, Iowa 50613-6951  
(319)-266-0161

SHINER = 8D NAIL & 1 5/16"Ø METAL SHINER  
BRASS TAG = 13/16"Ø BRASS TAG  
OPC = PLASTIC CAP (O=ORANGE, R=RED, Y=YELLOW)  
(00') RECORDED AS FILE NAME: 09-248C3.DWG

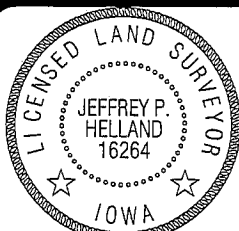

I hereby certify that this land surveying document was prepared  
and the related survey work was performed by me or under my  
direct personal supervision and that I am a duly licensed Land  
Surveyor under the laws of the State of Iowa.

Jeffrey P. Helland 10/14/09  
Jeffrey P. Helland  
License Number 16264  
My license renewal date is December 31, 2009.  
All pages or sheets are covered by this seal except:

### LIST CORNERS TO BE INDEXED:

CORNER	SECTION	TOWNSHIP	RANGE
N 1/4 CORNER	27	87N	13W
S 1/4 CORNER	22	87N	13W

(9.00)

Rec