

SC ✓
Misc ✓
INDEX ✓
MARGIN
PROOF ✓
COMPARE

BLACK HAWK COUNTY IOWA:SS
FILED FOR RECORD Mar 2, 1999 AT
4:00P.M AND RECORDED IN BOOK 333
OF Misc PAGE 506
FEE 1-5.00x
RECORDER
PAUL HELLAND

20547

Paul H. Helland, 1107 Technology Parkway, Cedar Falls, Iowa 50613-6951, (319)-266-0161

UNITED STATES PUBLIC LAND SURVEY CORNER CERTIFICATE
OF

LAND SURVEY MONUMENTS SITUATED IN SECTION NO. 33, TOWNSHIP NO. 87 NORTH, RANGE
NO. 13 WEST OF THE FIFTH PRINCIPAL MERIDIAN, BLACK HAWK COUNTY, IOWA.

PREVIOUSLY RECORDED IN BOOK, PAGE

(SHOW REASON FOR PREPARING THIS CERTIFICATE, THE EVIDENCE AND DETAILED PROCEDURES USED IN ESTABLISHING THE CORNER POSITIONS AND MONUMENTATION FOUND OR PLACED.)

MONUMENT DESCRIPTION AND REMARKS:

SURVEY DONE IN SW 1/4 OF SEC. 33-T87N-R13W


W 1/4 CORNER: FOUND NO. 4 REBAR 0.3' DEEP AS PER COUNTY TIES.

SW CORNER: FOUND CONCRETE MONUMENT W/BRASS CAP "32+33" 1.2' DEEP, SET NO. 4 REBAR ON NORTH SIDE FOR MAGNETIC DETECTION.

S 1/4 CORNER: FOUND CONCRETE MONUMENT W/BRASS CAP "33/4" FLUSH; SET NO. 4 REBAR ON NORTH SIDE FOR MAGNETIC DETECTION.

PLAN VIEW

(SHOW A MINIMUM OF THREE REFERENCE TIES TO DURABLE PHYSICAL OBJECTS, RELEVANT MONUMENTS AND PHYSICAL CONDITIONS THAT WILL ENABLE RECOVERY OF THE CORNER.)

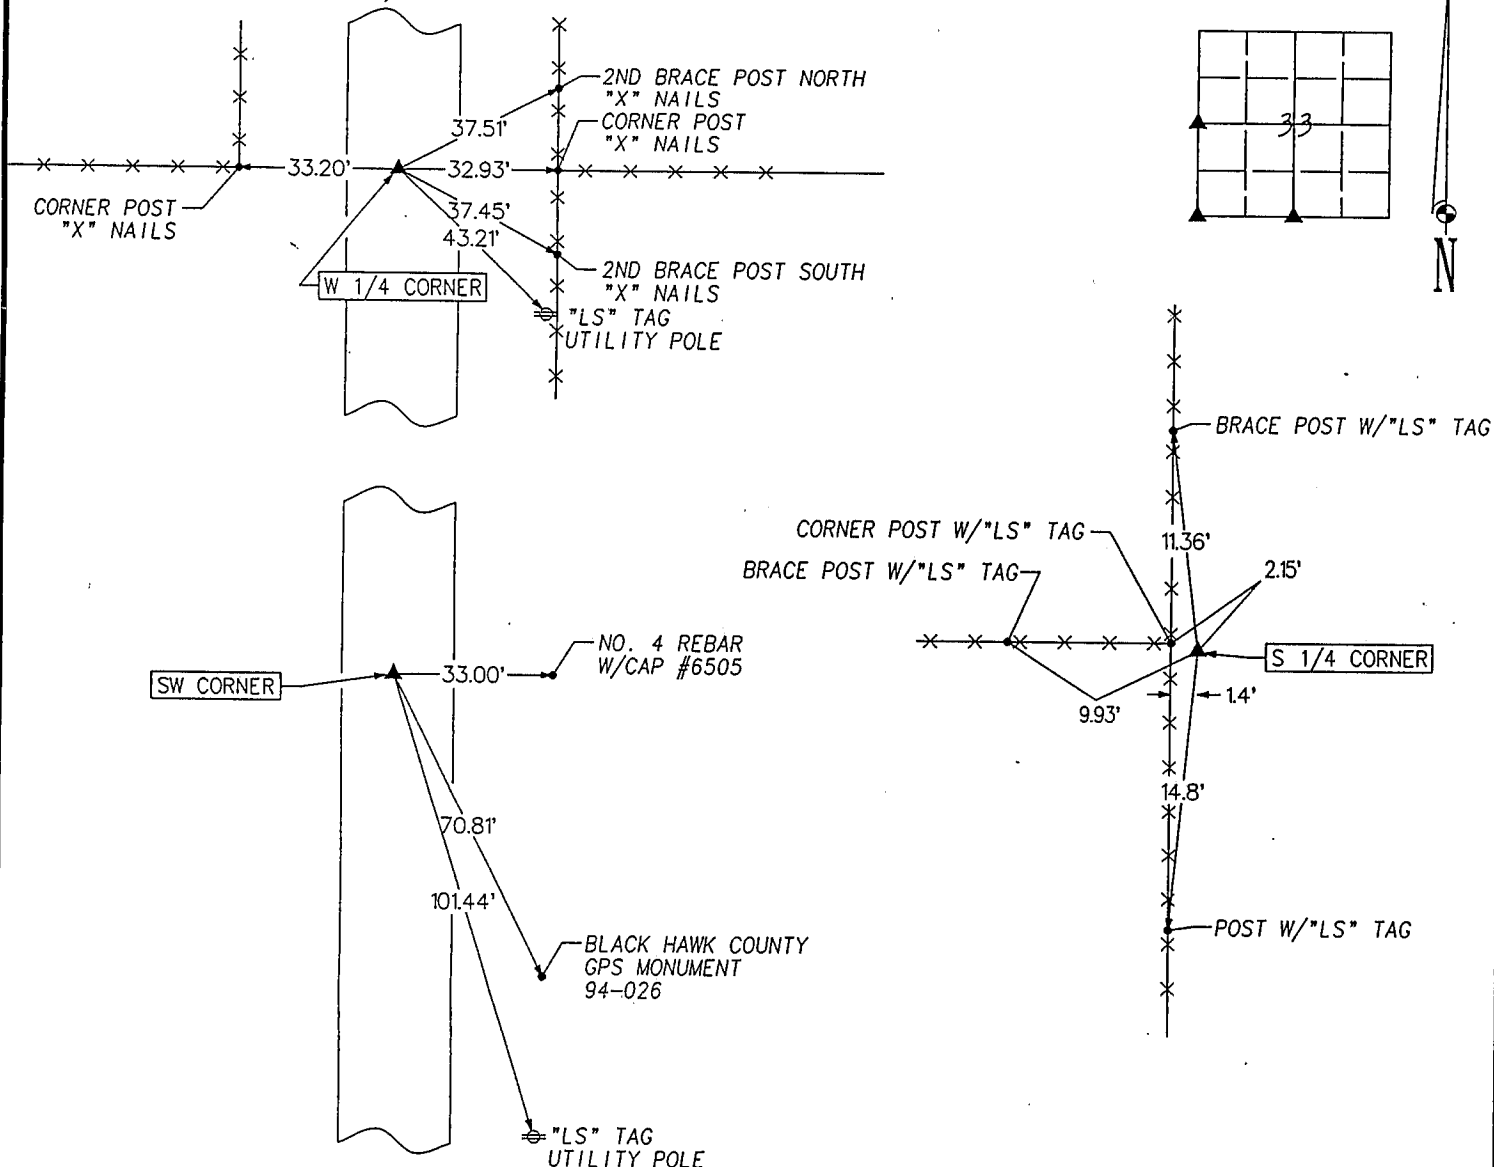

HELLAND ENGINEERING & SURVEYING, LTD.
1107 Technology Parkway
Cedar Falls, Iowa 50613-6951
(319)-266-0161



I hereby certify that this land surveying document was prepared and the related survey work was performed by me or under my direct personal supervision and that I am a duly licensed Land Surveyor under the laws of the State of Iowa.

Paul H. Helland 3/2/99
Paul H. Helland
License Number 6505

My license renewal date is December 31, 1999.
All pages or sheets are covered by this seal except:

LIST CORNERS TO BE INDEXED			
CORNER	SECTION	TOWNSHIP	RANGE
W 1/4 CORNER	33	87N	13W
SW CORNER	33	87N	13W
S 1/4 CORNER	33	87N	13W