I O

Document Number: 2009001126

Date: Jul 15, 2008 4:30:00 pm

Aud Fee: 0.00 Rec Fee:

Trans Tax: 0.00 Rec Management Fee: E-Com Fee: 0.00 Non-Standard Page Fee:

Z

Filed for record in Black Hawk County, Iowa
Judith A. McCarthy, County Recorder

PREPARED BY:

BLACK HAWK COUNTY ENGINEERS OFFICE

316 E. FIFTH STREET, ROOM 211 WATERLOO, IOWA 50703

PH.# (319) 833-3008 FAX.# (319) 833-3139

SLSI 9-94 CERT 12-96

0.00

0.00

UNITED STATES PUBLIC LAND SURVEY CORNER CERTIFICATE OF

Land Survey Monuments situated in Section____34___, Township__87 N__, Range__13 W__, of the Fifth Principal Meridian, BLACK HAWK County, Iowa. Previously recorded in Fee Book 2005., Page 28525, in County Recorder's Office.

(Show reason for preparing this certificate, the evidence and detailed procedures used in establishing the corner positions and monumentation found or placed.)

Monument Description and Remarks: N. 1/4 COR.: FND. P.C.C. NAIL (ROUND HEAD) PER CURRENT RECORD, LOC. .32' S. OF C.L. EXIST. P.C.C. JOINT.

CORNER TEMP. REFERENCED AND RE-TIED AS SHOWN, PRIOR TO ACC RESURF.


PROJECT. RESET 5.5" L. 5/8" REBAR LOC. ±0.20' SOUTH OF C.L. ACC PVM'T. JOINT.

PLAN - VIEW


(Show a minimum of three reference ties to durable physical objects, relevant monuments and physical conditions that will enable recovery of the corner.)

- 1.) TIES PER EDM MEASURE IN EITHER PRISM "OR" NON-PRISM MODE, WHILE UTILIZING "DIRECT" MEASURE, WITH ALL DISTANCES PLUMB/HORIZ. (HD), UNLESS DENOTED.
- 2.) SECTION LINE MEASURE REFERS
 TO "LOCAL GROUND" DIST. AND
 INCLUDES ELLIPSDIDAL (COMBINED)
 SCALE FACTOR FROM S.P.C. GRID
 INVERSE (AS OBSERVED, PER AVG.
 SCALE FACTOR = 1.0000768161407)
- 3.) "R" = DENOTES "RECORD" MEAS./TIE
 "M" = MEASURED VALUE OBSERVED
 "SM" = SURVEY MARKER

NOT TO SCALE

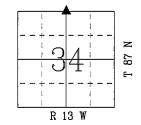

TIE UTIL. I.D.O.T. #4
RBR. R.O.W. COR.
@ CENTER ALUM.
CAP.

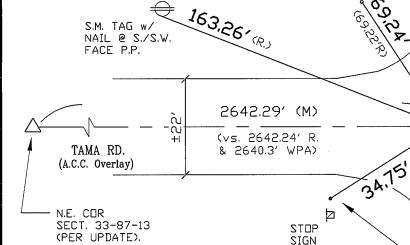

S.P.C., la. N. Zone, USft N=3578843.26'

E=5232908.36'

(NAD83-2007 "BHco07", RTK Obs.)

33.6′ (+/-) 180°01′06″ (M) IANES OF HWY.#21

FIELD SURVEY:

G.T. & J.Z. 07/10/08

C.L.


N.E. C□R 34-87-13

(PER UPDATE).

PREPARED BY: G.T. & J.Z. 7/15/08

2649.35⁽ (M) (vs. 2649.1⁽ | WPA)

CERTIFICATION

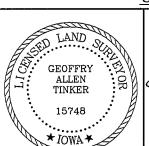

I hereby certify that this land surveying document was prepared and the related survey work was performed by me or under my direct personal supervision and that I am a duly licensed Land Surveyor under the laws of the State of Iowa.

SET #5 RBR. @ ±2' N. DF STDP SIGN

2008

POST.

Geoffry Allen Tikker

15748

My license renewal date is December 31, 2008

Pages or sheets covered by this seal:

This Land Corner Certificate Only.

LIST CORNERS TO BE INDEXED

 Corner
 Section
 - Township
 - Range

 N. 1/4
 34
 87 N
 13 W

 S. 1/4
 27
 87 N
 13 W