

I
P
Z

Document Number: 2009001132
Date: Jul 15, 2008 4:30:00 pm
Aud Fee: 0.00 Rec Fee: 0.00
Trans Tax: 0.00 Rec Management Fee: 0.00
E-Com Fee: 0.00 Non-Standard Page Fee: 0.00
Filed for record in Black Hawk County, Iowa
Judith A. McCarthy, County Recorder

PREPARED BY: BLACK HAWK COUNTY ENGINEERS OFFICE
316 E. FIFTH STREET, ROOM 211 WATERLOO, IOWA 50703

PH.# (319) 291-2419 SLSI 9-94
FAX.# (319) 291-2461 CERT 12-96

UNITED STATES PUBLIC LAND SURVEY CORNER CERTIFICATE OF
Land Survey Monuments situated in Section 35, Township 87 N,
Range 13 W, of the Fifth Principal Meridian, BLACK HAWK County, Iowa.
Previously recorded in Misc. Book 332, Page 304, in County Recorder's Office.


(Show reason for preparing this certificate, the evidence and detailed procedures used in establishing the corner positions and monumentation found or placed.)

Monument Description and Remarks: N.E. CORNER: RECORD BH. CO. ENG. TIES
REF. CORNER BEING RE-SET FROM N. 1/4'S BOTH EAST & WEST & RECORD
TIES AT TWO LOCATIONS. FND. RECORD #5 REBAR PER CURRENT RECORD
AND TEMP. REFERENCED & RETIED AS SHOWN, PRIOR TO HMA/ACC RESURF.
PROJECT. RESET CORNER w/ 7" L. - 5/8" REBAR LOC. 0.30' N. OF CL. ACC
JOINT, AND ALIGNED WITH SIDEROAD C.L. (±) N-S (HESS RD.).

PLAN - VIEW

(Show a minimum of three reference ties to durable physical objects, relevant monuments and physical conditions that will enable recovery of the corner.)

- 1.) TIES PER EDM MEASURE IN EITHER PRISM "OR" NON-PRISM MODE, WHILE UTILIZING "INDIRECT" MEASURE, WITH ALL DISTANCES PLUMB/HORIZ. (HD), UNLESS DENOTED.
- 2.) SECTION LINE MEASURE REFERS TO "LOCAL GROUND" DIST. AND INCLUDES ELLIPSOIDAL (COMBINED) SCALE FACTOR FROM S.P.C. GRID INVERSE (AS OBSERVED, PER AVG. SCALE FACTOR = 1.0000768161407)
- 3.) "R" = DENOTES "RECORD" MEAS./TIE
"M" = MEASURED VALUE OBSERVED

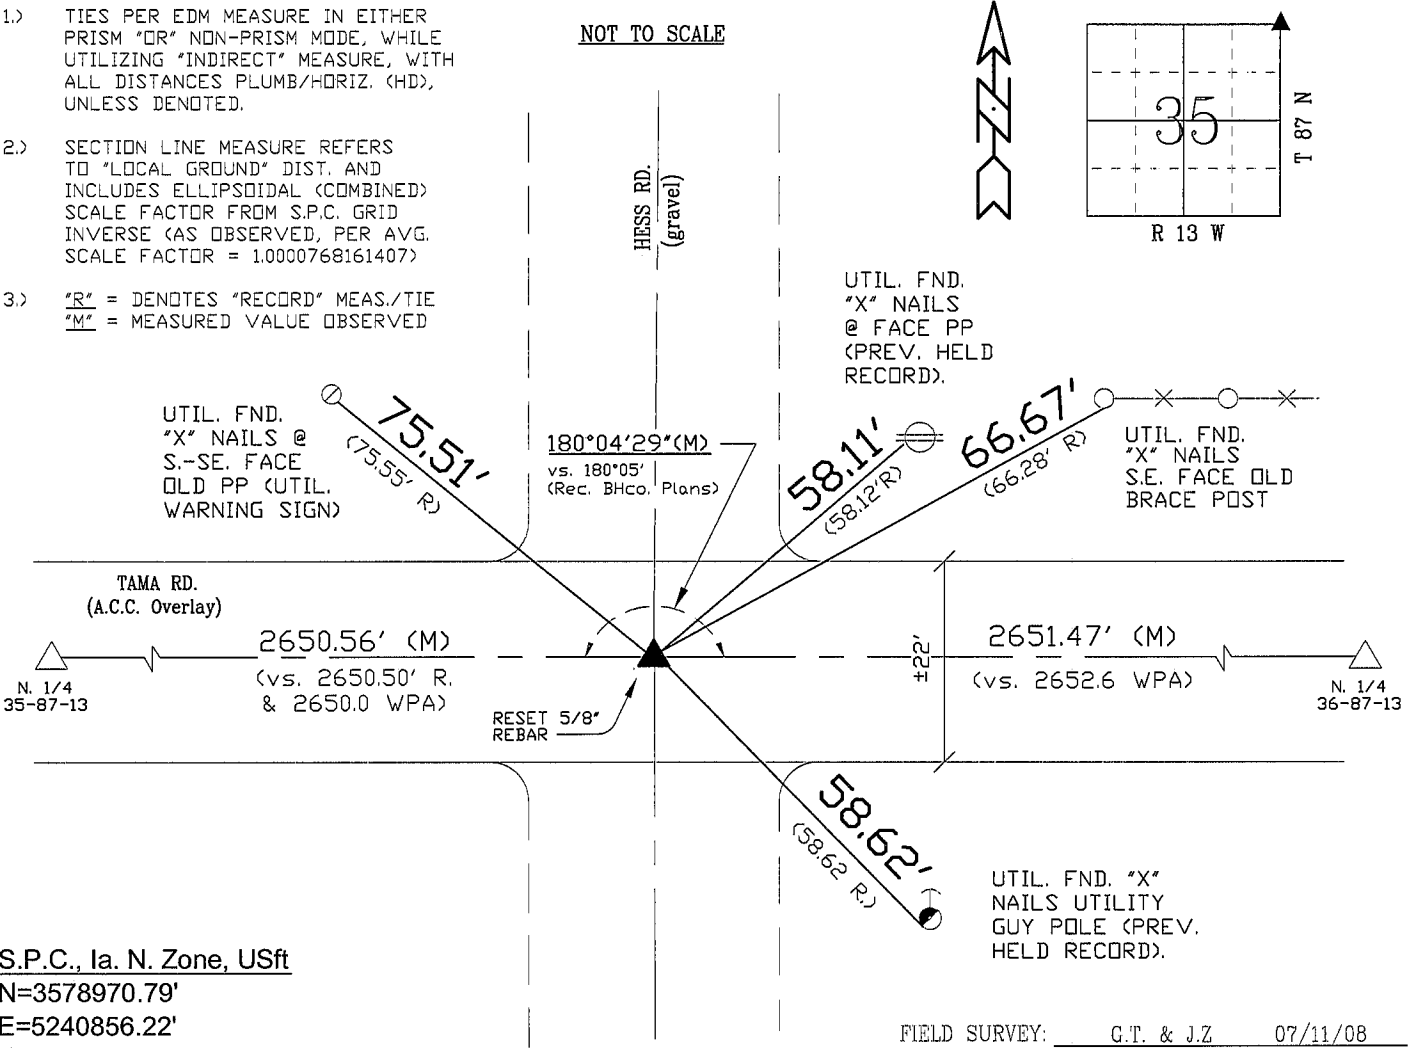

S.P.C., Ia. N. Zone, USft
N=3578970.79'
E=5240856.22'
(NAD83-2007 "BHco07", RTK Obs.)

FIELD SURVEY: G.T. & J.Z 07/11/08
PREPARED BY: G.T. & J.Z 7/15/08

CERTIFICATION



I hereby certify that this land surveying document was prepared and the related survey work was performed by me or under my direct personal supervision and that I am a duly licensed Land Surveyor under the laws of the State of Iowa.
Geoffrey Allen Tinker 7/15/2008
Geoffrey Allen Tinker (date)
License Number 15748
My license renewal date is December 31, 2008
Pages or sheets covered by this seal:
This Land Corner Certificate Only.

LIST CORNERS TO BE INDEXED

Corner	Section	Township	Range
N.E. COR.	35	87 N	13 W
S.E. COR.	26	87 N	13 W
N.W. COR.	36	87 N	13 W
S.W. COR.	25	87 N	13 W