

10
P
Z

Document Number: 2007027123
Date: Jun 20, 2007 4:30:00 pm
Aud Fee: 0.00 Rec Fee: 0.00
Trans Tax: 0.00 Rec Management Fee: 0.00
E-Com Fee: 0.00 Non-Standard Page Fee: 0.00
Filed for record in Black Hawk County, Iowa
Judith A. McCarthy, County Recorder

PREPARED BY: BLACK HAWK COUNTY ENGINEERS OFFICE PH.# (319) 833-3008 SLSI 9-94
316 E. FIFTH STREET, ROOM 211 WATERLOO, IOWA 50703 FAX.# (319) 833-3139 CERT 12-96

UNITED STATES PUBLIC LAND SURVEY CORNER CERTIFICATE OF
Land Survey Monuments situated in Section 36, Township 87 N,
Range 13 W, of the Fifth Principal Meridian, BLACK HAWK County, Iowa.
Previously recorded in Misc. Book n/a, Page n/a, in County Recorder's Office.

(Show reason for preparing this certificate, the evidence and detailed procedures used in establishing the corner positions and monumentation found or placed.)


Monument Description and Remarks: FND. #5 RBR @ CENTERLINE INTERSECTION
PRIOR TO RESURF. PROJECT. RE-SET #5 REBAR x 6" L., LOC. 0.20' EAST OF C.L.
N/S ACC JOINT & ALIGNED ± w/C.L. JOINTS E/W ON TAMA RD.
CORNER TEMP. REF. AND RETIED AS DENOTED, DUE TO PLAN 5½" HMA RESURFACING.
RECORD CO. TIES REFERENCED FROM FND. CORNER, AS DENOTED BELOW.

PLAN - VIEW


(Show a minimum of three reference ties to durable physical objects, relevant monuments and physical conditions that will enable recovery of the corner.)

NOTES:

- 1.) TIES PER EDM MEASURE IN. REFLECTORLESS MODE, UTIL. INDIRECT MEASURE (M.L.M.).
- 2.) SECTION LINE DISTANCE REFERS TO "LOCAL GROUND" MEAS. AND INCLUDES ELLIPSOIDAL (COMBINED) SCALE FACTOR FROM NAD83 S.P.C. GRID INVERSE (AS OBSERVED).
- 3.) "R" = DENOTES RECORD MEAS./TIE PER B.H. CO. ENGINEER RED DOT BOOK, DTD. "1984".

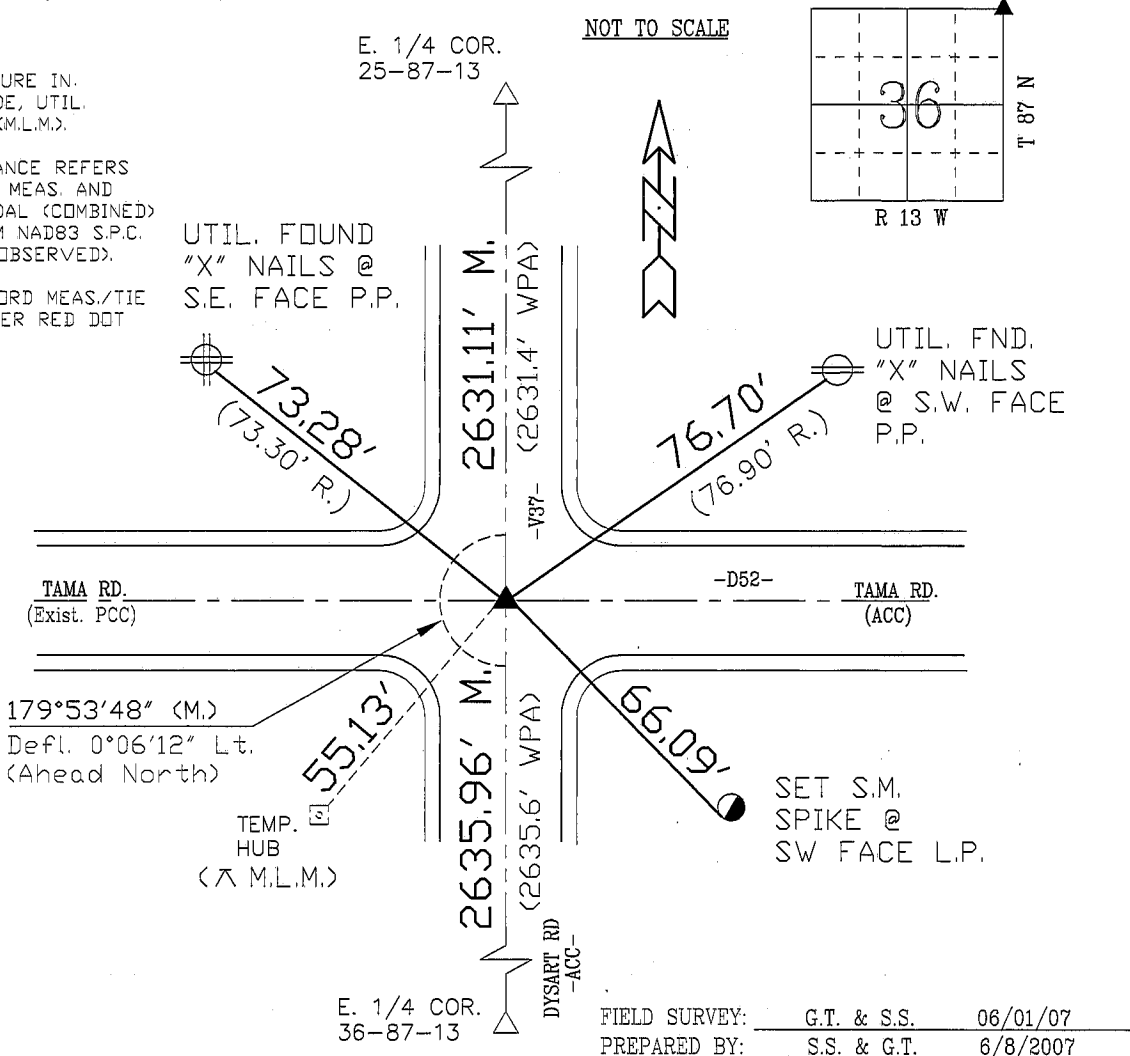

CERTIFICATION

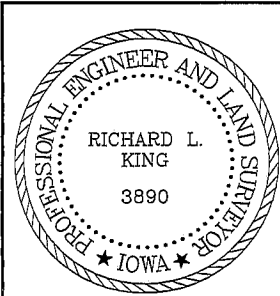

I hereby certify that this land surveying document was prepared and the related survey work was performed by me or under my direct personal supervision and that I am a duly licensed Land Surveyor under the laws of the State of Iowa.
Richard L. King
License Number 3890
My license renewal date is December 31, 2007
Pages or sheets covered by this seal:
This Land Corner Certificate Only.

LIST CORNERS TO BE INDEXED

Corner	Section	Township	Range
N.E. COR.	36	87 N	13 W
S.W. COR.	30	87 N	12 W
S.E. COR.	25	87 N	13 W
N.W. COR.	31	87 N	12 W