SC MISC INDEX 11 MARGIN PROOF9T COMPARE 11

014923 BLACK HAWK COUNTY IOWA:SS ,2000 at Filed for record JAN 11 4:00 P. M. and recorded in Book 336 MISC Page 874 toliel Recorder N/C FEE RECEIVED ENGINEER'S OFFICE **BLACK HAWK COUNT ASSESSOR**

PREPARED BY:

BLACK HAWK COUNTY ENGINEERS OFFICE 316 E. FIFTH STREET, ROOM 211 WATE

WATERLOO, IOWA 50703

PH.# (319) 833-3008 FAX.# (319) 833-3139

SLSI 9-94 CERT 12-96

UNITED STATES PUBLIC LAND SURVEY CORNER CERTIFICATE OF

Land Survey Monuments situated in Section 01, Township 87 N, Range 14 W, of the Fifth Principal Meridian, BLACK HAWK County, Iowa. Previously recorded in Misc. Book N/A, Page N/A, in County Recorder's Office.

(Show reason for preparing this certificate, the evidence and detailed procedures used in establishing the corner positions and monumentation found or placed.)

Monument Description and Remarks: N. 1/4 CORNER SECT. 01-87-14

FOUND C.M. w/ TOP BROKE. UTILIZED EXISTING TIES AS DENOTED BELOW.

EST. 5/8' RBR. N. FACE BELOW BREAK FOR MAGNETIC LOCATION. SET TACK


C.L. TOP OF MON. RECOVERED FROM RECORD TIES OF AUG. 24, 1938.

C.M. SET FROM CENTER OF 36-88-14 BY DOUBLED 1/4-1/4 DIST. OF 1319.4'.

NORTH R-O-W FNC. @ 2616.4' (+) 22.4' (2638.8') C.L. RD.

PLAN - VIEW

(Show a minimum of three reference ties to durable physical objects, relevant monuments and physical conditions that will enable recovery of the corner.)

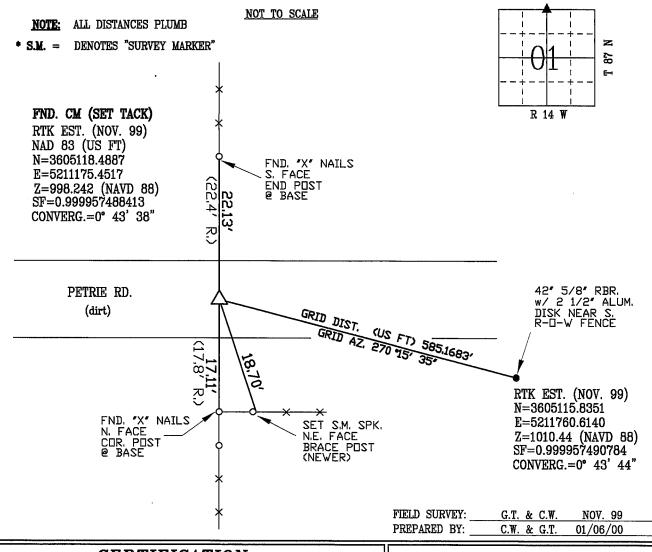

CERTIFICATION

RICHARD L. SING SHAPE SH

I hereby certify that this land surveying document was prepared and the related survey work was performed by me or under my direct personal supervision and that I am a duly licensed Land Surveyor under the laws of the State of Iowa.

Richard L. King
License Number 3890

My license renewal date is December 31, 2001

Pages or sheets covered by this seal:

This Land Corner Certificate Only.

LIST CORNERS TO BE INDEXED

<u>Corner</u> <u>Section</u> - <u>Township</u> - <u>Range</u>

N. 1/4 01 87 N 14 W