

SC  
MISC  
INDEX VS  
MARGIN  
PROOF  
COMPARE

BLACK HAWK COUNTY IOWA:SS  
Filed for record FEB 21, 2002 at  
3:00 P.M. and recorded in Book 345  
of MISC Page 742  
*Patricia J. Soss* Recorder  
Fee 1-5.00X  
HELLAND ENGINEERING & SURVEYING

Paul H. Helland, 1107 Technology Parkway, Cedar Falls, Iowa 50613-6951, (319)-266-0161

## UNITED STATES PUBLIC LAND SURVEY CORNER CERTIFICATE OF

LAND SURVEY MONUMENTS SITUATED IN SECTION NO. 3, TOWNSHIP NO. 87 NORTH, RANGE  
NO. 14 WEST OF THE FIFTH PRINCIPAL MERIDIAN, BLACK HAWK COUNTY, IOWA.

PREVIOUSLY RECORDED IN BOOK \_\_\_\_\_, PAGE \_\_\_\_\_.

(SHOW REASON FOR PREPARING THIS CERTIFICATE, THE EVIDENCE AND DETAILED PROCEDURES USED IN ESTABLISHING THE  
CORNER POSITIONS AND MONUMENTATION FOUND OR PLACED.)


### MONUMENT DESCRIPTION AND REMARKS:

SURVEY DONE IN SW 1/4 OF SEC. 2-T87N-R14W.

E 1/4 CORNER: Black Hawk County Engineer reference ties obliterated by construction of U.S. Highway #63. WPA Notes dated 8/24/1938 call for a lead plug in centerline of pavement. U.S. Highway #63 relocated since 1938. Using "I.D.O.T." right-of-way information, started excavation 113.4' West of R.O.W. rail to the East in line w/fence running East from said rail. Found 5/8" square pin 3.7' deep (found pointed limestone just to the SW of found pin 2.1' deep). Set No. 4 rebar w/orange cap #6505 (0.5' deep) above found 5/8" square pin. Corner is 20.6' ± West of West edge A.C.C. pavement.

### PLAN VIEW

(SHOW A MINIMUM OF THREE REFERENCE TIES TO DURABLE PHYSICAL OBJECTS, RELEVANT MONUMENTS AND PHYSICAL  
CONDITIONS THAT WILL ENABLE RECOVERY OF THE CORNER.)

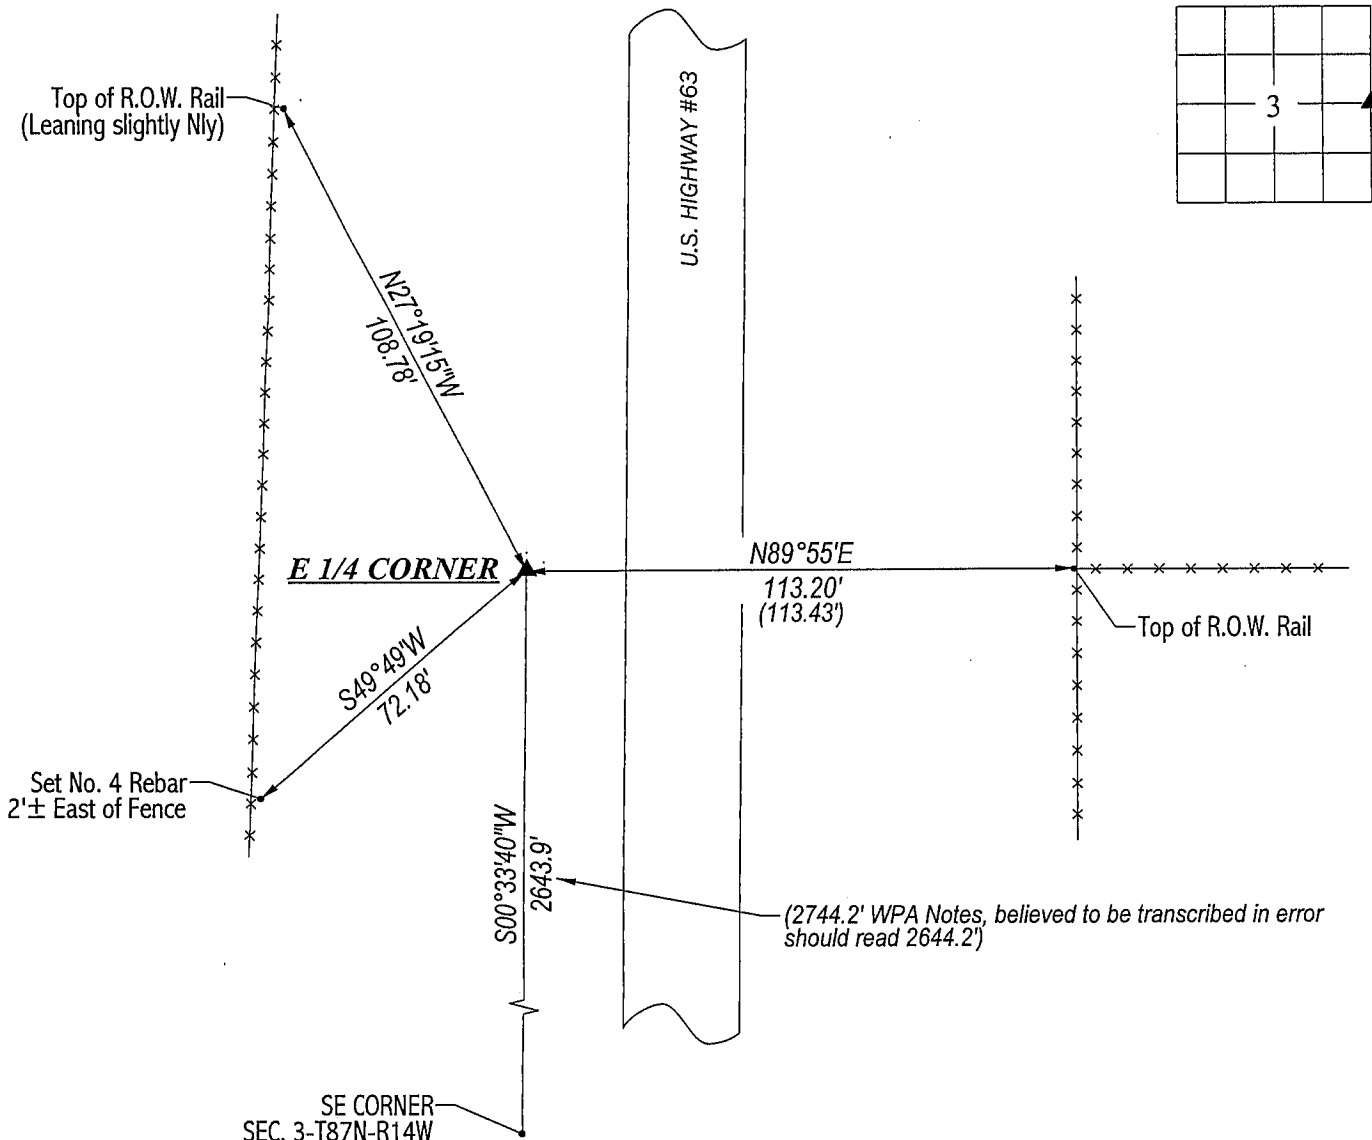

HELLAND ENGINEERING & SURVEYING, LTD.  
1107 Technology Parkway  
Cedar Falls, Iowa 50613-6951  
(319)-266-0161

FILE NAME: 01-316C2.DRG



I hereby certify that this land surveying document was prepared  
and the related survey work was performed by me or under my  
direct personal supervision and that I am a duly licensed Land  
Surveyor under the laws of the State of Iowa.

*Paul H. Helland 2/14/02*  
Paul H. Helland  
License Number 6505  
My license renewal date is December 31, 2001.  
All pages or sheets are covered by this seal except:

LIST CORNERS TO BE INDEXED  
CORNER SECTION TOWNSHIP RANGE  
E 1/4 CORNER 3 87N 14W

BOOK 345 742