

TEKIPPE ENGINEERING PC 128 SOUTH VINE ST WEST UNION, IA 52175

TeKIPPE ENGINEERING, P.C., 128 South Vine Street, West Union, Iowa 52175 Phone (563) 422-5131

UNITED STATES PUBLIC LAND SURVEY CORNER CERTIFICATE

OF

Land Survey Monuments situated in Section 3, Township 87 North, Range 14 West of the Fifth Principal Meridian, BLACK HAWK County, Iowa.
Previously recorded in none in County Recorder's Office.
(book, page, document number, etc.)


(Show reason for preparing this certificate, the evidence and detailed procedures used in establishing the corner positions and monumentation found or placed.)

Monument Description and Remarks: **S 1/4 Corner Section 3 T87N R14W:** Found 1"Ø iron bar with information obtained from the Black Hawk County Engineer's Office in the Field Book for Township 87 North, Range 14 West, Page 25.


PLAN - VIEW

Project Number 02122.LS
FB. 52A PG. 32-33

(Show a minimum of three reference ties to durable physical objects, relevant monuments and physical conditions that will enable recovery of the corner.)

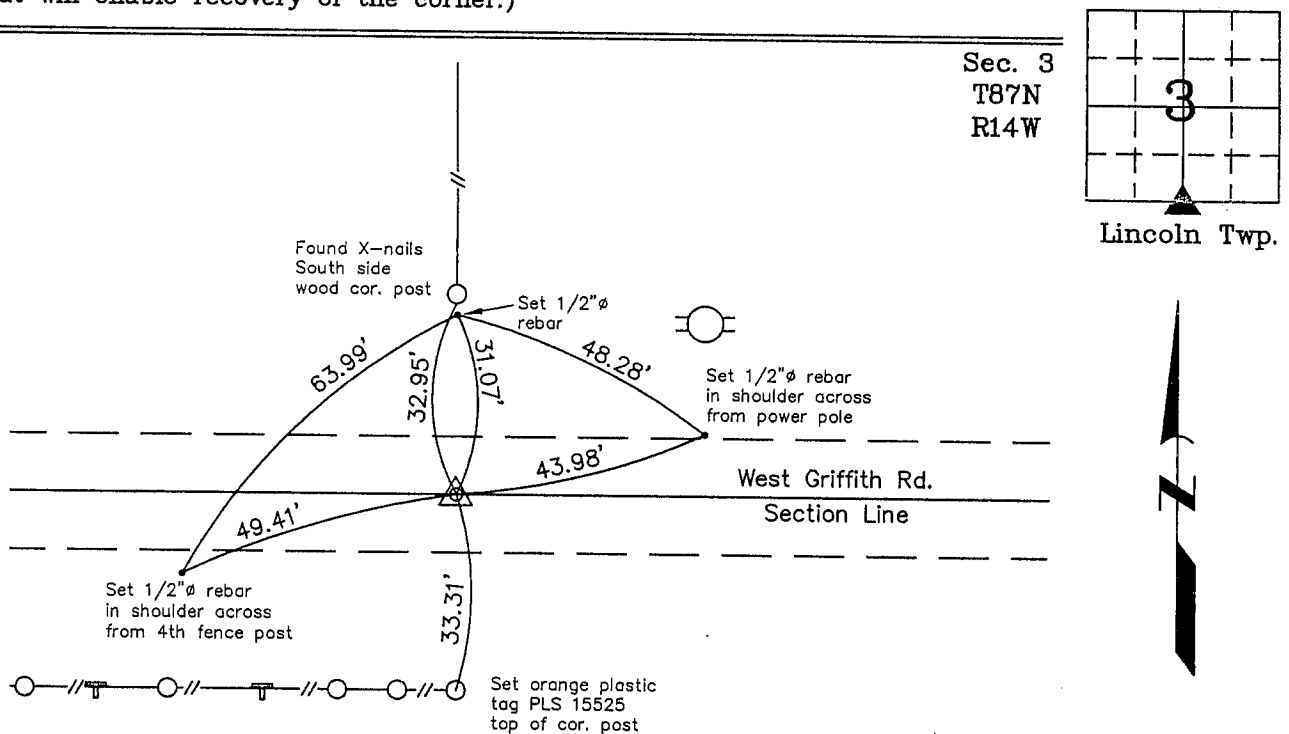

S 1/4 Corner Section 3 T87N R14W
Found 1"Ø iron bar

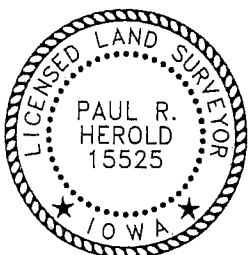

I hereby certify that this land surveying document was prepared and the related survey work was performed by me or under my direct personal supervision and that I am a duly licensed Land Surveyor under the laws of the State of Iowa.

Paul R. Herold 6-6-02
Paul R. Herold Date
License number 15525
My license renewal date is December 31, 2002.
Sheets covered by this seal: Individual

Corners	Section	Twp.	Range
S 1/4	3	87N	14W

X:\Section Corners\Sec. 03\38714w.dwg