

BLACK HAWK COUNTY IOWA:SS

Filed for record JUL 20, 2000 at

1:00 P.M. and recorded in Book

of Page

INDEX
MARGIN
PROOF
COMPARE

FEE 1-5.00/

WAYNE CLAASSEN ENGINEERING AND SURVEYING INC

WAYNE CLAASSEN ENGINEERING AND SURVEYING, INC.
P.O. BOX 898, WATERLOO, IOWA 50704-0898PHONE: (VOICE) 319-235-6294
(FAX) 319-235-0028

UNITED STATES PUBLIC LAND SURVEY CORNER CERTIFICATE


Land Survey Monuments situated in Section 6, Township 87N, Range 14W, of the Fifth Principal Meridian, BLACK HAWK County, Iowa.Previously recorded in N/A in County Recorder's Office.
(book, page, document number, etc.)

(Show reason for preparing this certificate, the evidence and detailed procedures used in establishing the corner positions and monumentation found or placed.)

Monument Description and Remarks SE COR. NE FRL 1/4 NW FRL 1/4, Set 1/2" x 24" rebar & cap #8033 on line prorated dist. (gov't meas) between N 1/4 Cor. & Center section. Gov't dist to ctr. sec = 20 ch, to N 1/4 Cor = 23.88 ch, Center calc at inters E 1/4 - W 1/4 & S 1/4 - N 1/4. This point is approx 31.5' West of old N-S fence & 4.3' N. of old E-W fence. Set survey marker sign & steel post 1' South. Property owners are aware of this difference.

PLAN - VIEW

(Show a minimum of three reference ties to durable physical objects, relevant monuments and physical conditions that will enable recovery of the corner.)

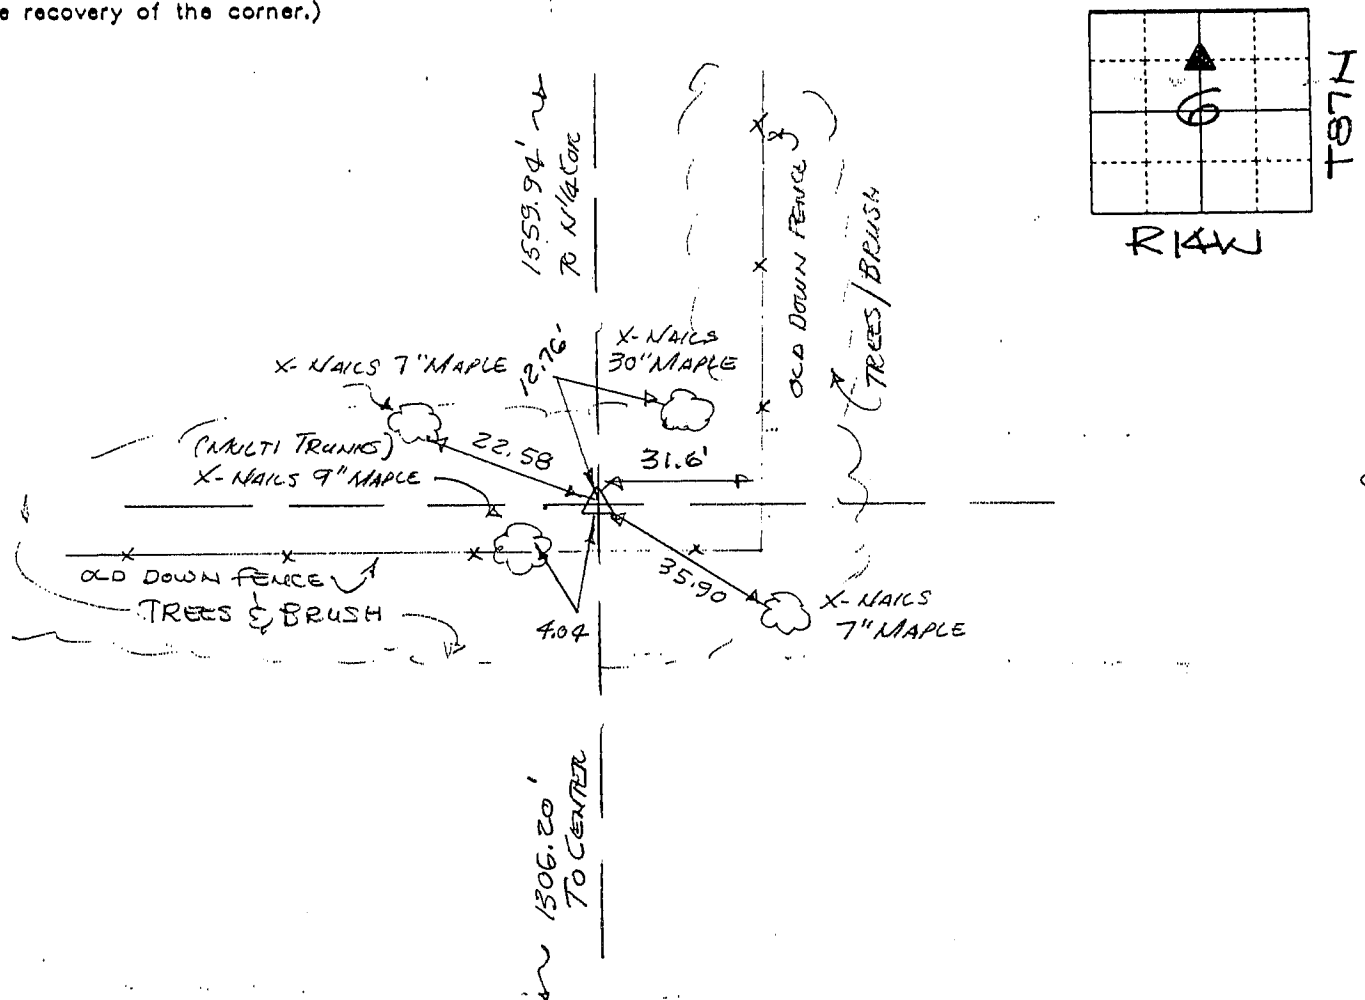

484-53

I hereby certify that the survey work was completed and this certificate was prepared by me or under my direct personal supervision and that I am a duly licensed land surveyor under the laws of the state of Iowa.

Signature:


(Name typed or printed:) F. WILLIAM KING

Date: JULY 14, 2000 Lic. No. 8033

List Corners to be Indexed

Corners	Section	Twp	Range
SE COR. OF NE FRL 1/4 OF NW FRL 1/4	6	87N	14W

SEAL

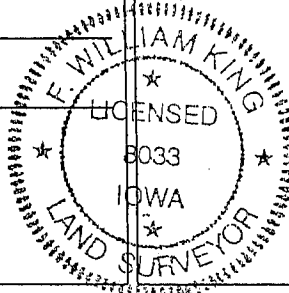

BOOK 339 PAGE 372