

001308

BLACK HAWK COUNTY IOWA:SS

Filed for record JUL 20, 2000 at
1:00 P.M. and recorded in Book

of Page

INDEX
MARGIN
PROOF
COMPAREof William S. King RECORDER

FEE 1-5.00/

WAYNE CLAASSEN ENGINEERING AND SURVEYING INC

WAYNE CLAASSEN ENGINEERING AND SURVEYING, INC.
P.O. BOX 898 WATERLOO, IOWA 50704-0898PHONE: (VOICE) 319-235-6294
(FAX) 319-235-0028

UNITED STATES PUBLIC LAND SURVEY CORNER CERTIFICATE



nd Survey Monuments situated in Section 6, Township 87N, Range 14W, of the Fifth Principal Meridian, BLACK HAWK County, Iowa.
Previously recorded in N/A in County Recorder's Office.
(book, page, document number, etc.)

Now reason for preparing this certificate, the evidence and detailed procedures used in establishing the corner positions and monumentation found or placed.)

Monument Description and Remarks E 1/4 Cor. 5cm was found 2.3' deep with 1" open pipe on north side, set 1/2" rebar & cap #8033 above, at 2" below surface. This monument was found by F.W. King 10-29-1977 with top 18" broken off. Top was reset then on base with 1" iron pipe on north side.

PLAN - VIEW


Now a minimum of three reference ties to durable physical objects, relevant monuments and physical conditions that enable recovery of the corner.)

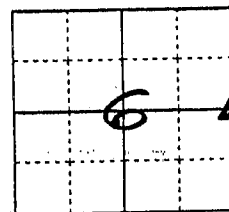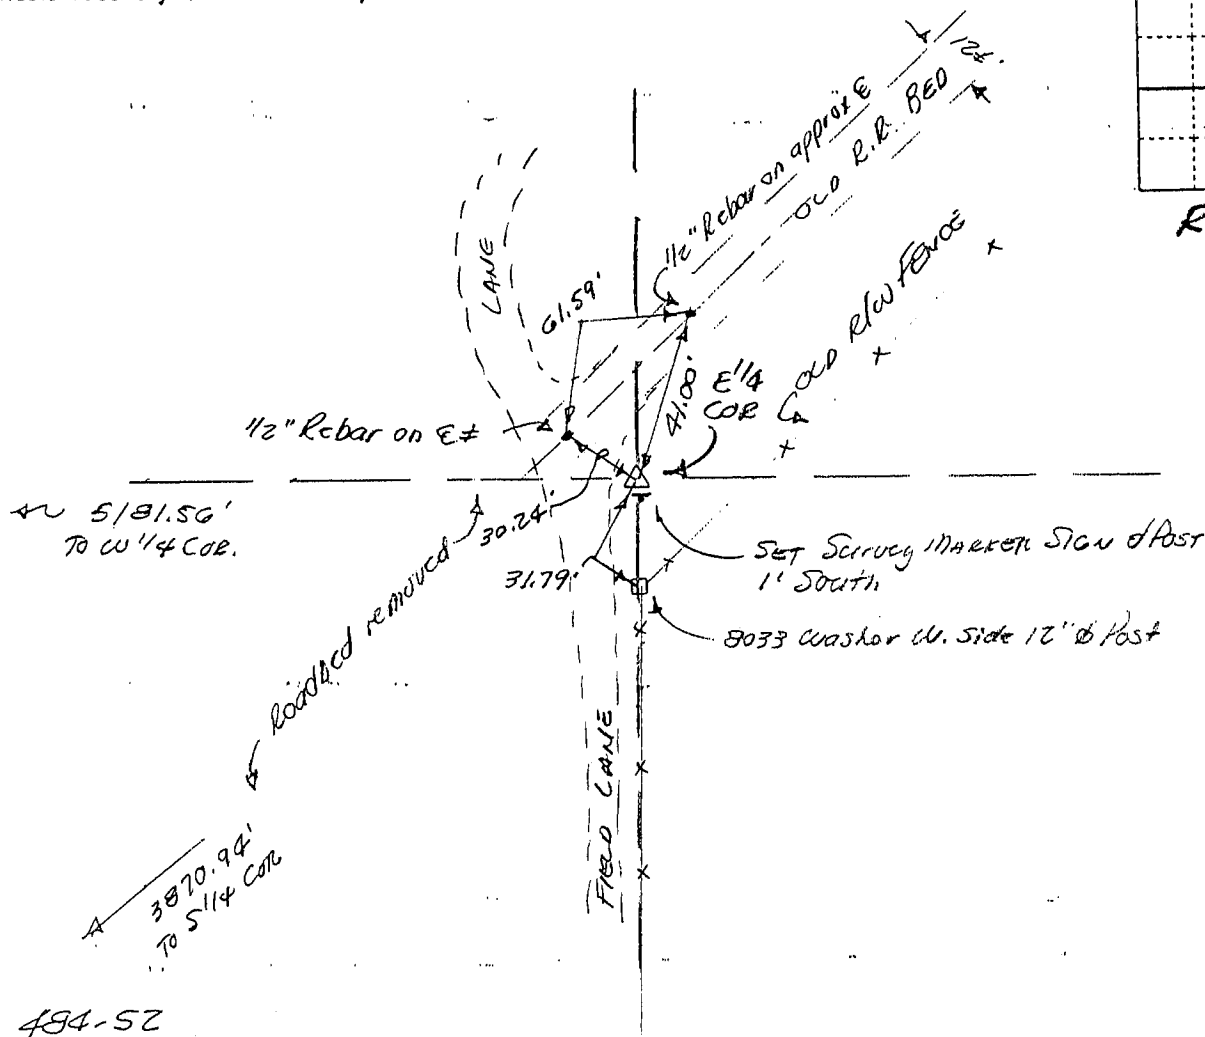

I hereby certify that the survey work was completed and this certificate was prepared by me or under my direct personal supervision and that I am a duly licensed land surveyor under the laws of the state of Iowa.

Signature:

F. William King
(Name typed or printed:) F. William King

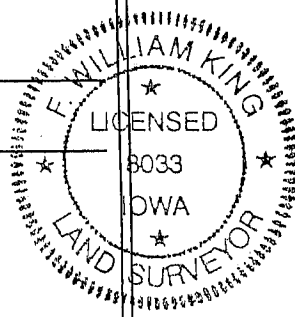Date: July 3, 2000Lic. No. 8033

List Corners to be Indexed

Corners	Section	Twp.	Range
E 1/4	6	87N	14W

SEAL

BOOK 339 PAGE 370