

INDEX
MARGIN
PROOF
COMPARE

WAYNE CLAASSEN ENGINEERING AND SURVEYING, INC.
P.O. BOX 898 WATERLOO, IOWA 50704-0898

PHONE: (VOICE) 319-235-6294
(FAX) 319-235-0028

UNITED STATES PUBLIC LAND SURVEY CORNER CERTIFICATE


and Survey Monuments situated in Section 6, Township 87N, Range 14W, of the Fifth Principal Meridian, Black Hawk County, Iowa.
Previously recorded in N/A in County Recorder's Office.
(book, page, document number, etc.)

Show reason for preparing this certificate, the evidence and detailed procedures used in establishing the corner positions and monumentation found or placed.)

Monument Description and Remarks N¹/₄ Cor. 6-87-14, found SCM, 4" deep. Set
Steel post & survey marker sign 1' North of monument.

PLAN - VIEW

Show a minimum of three reference ties to durable physical objects, relevant monuments and physical conditions that will enable recovery of the corner.)

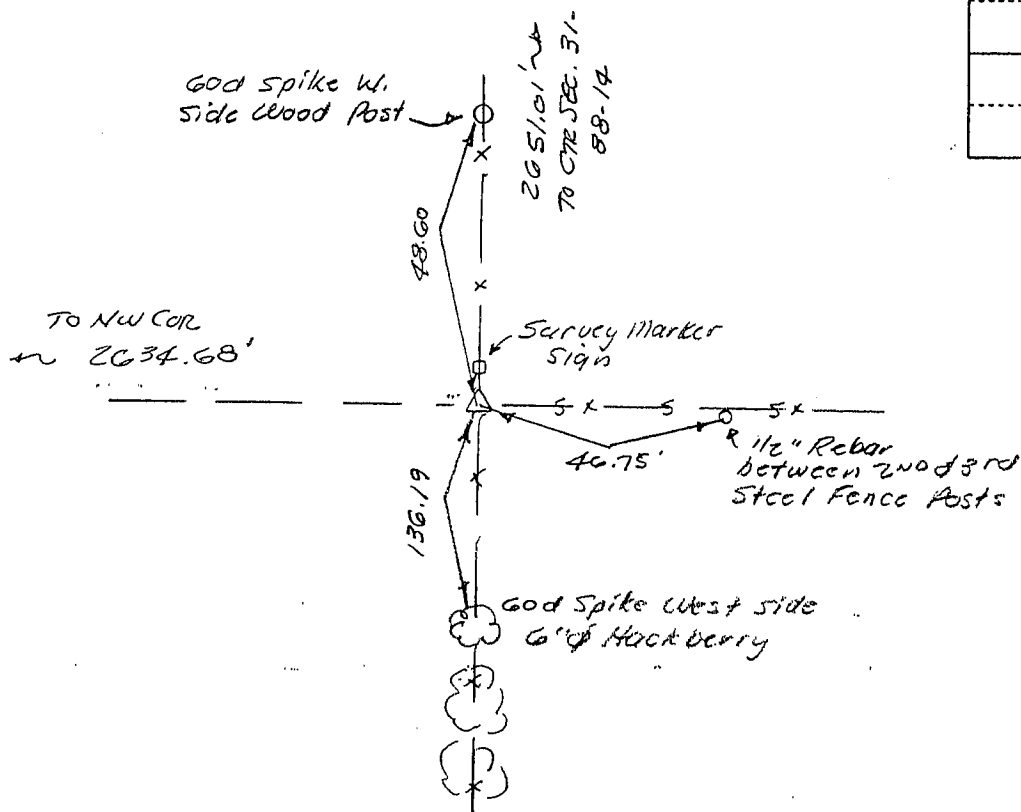


484-51

I hereby certify that the survey work was completed and this certificate was prepared by me or under my direct personal supervision and that I am a duly licensed land surveyor under the laws of the state of Iowa.

Signature: F. William King
(Name typed or printed:) F. WILLIAM KING

Date: June 30, 2000 Lic. No. 8033

SEAL

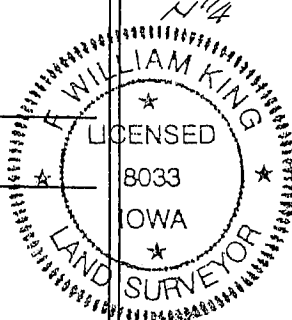

List Corners to be Indexed

Corners	Section	Twp	Range
<u>N¹/₄</u>	<u>6</u>	<u>87N</u>	<u>14W</u>

BOOK 339 PAGE 369