

INDEX
MARGIN
PROOF
COMPARE

WAYNE CLAASSEN ENGINEERING AND SURVEYING, INC.
P.O. BOX 898 WATERLOO, IOWA 50704-0898

PHONE: (VOICE) 319-235-6294
(FAX) 319-235-0028

UNITED STATES PUBLIC LAND SURVEY CORNER CERTIFICATE


Land Survey Monuments situated in Section 6, Township 87N, Range 14W, of the Fifth Principal Meridian, BLACK HAWK County, Iowa.
Previously recorded in N/A in County Recorder's Office.
(book, page, document number, etc.)

(Show reason for preparing this certificate, the evidence and detailed procedures used in establishing the corner positions and monumentation found or placed.)

Monument Description and Remarks SW COR. NE FRL 1/4 NW FRL 1/4, SET 1/2" Ø x 24" REBAR W/ CAP 8033
@ Intersection of E-W & N-S Mid POINTS (PER GOV'T MEAS.) OF NW FRL 1/4. This
location is 79' west of old N-S fence. This fence appears to be the southerly extension
of the west line of the E 1/2 (Gov't Meas.) of SW FRL 1/4 SEC. 31 to North, aerial photo &
comps indicate this. Property owners and their attorney are aware of this difference.
Survey marker sign & steel post were set 1' South.

PLAN - VIEW

(Show a minimum of three reference ties to durable physical objects, relevant monuments and physical conditions that will enable recovery of the corner.)

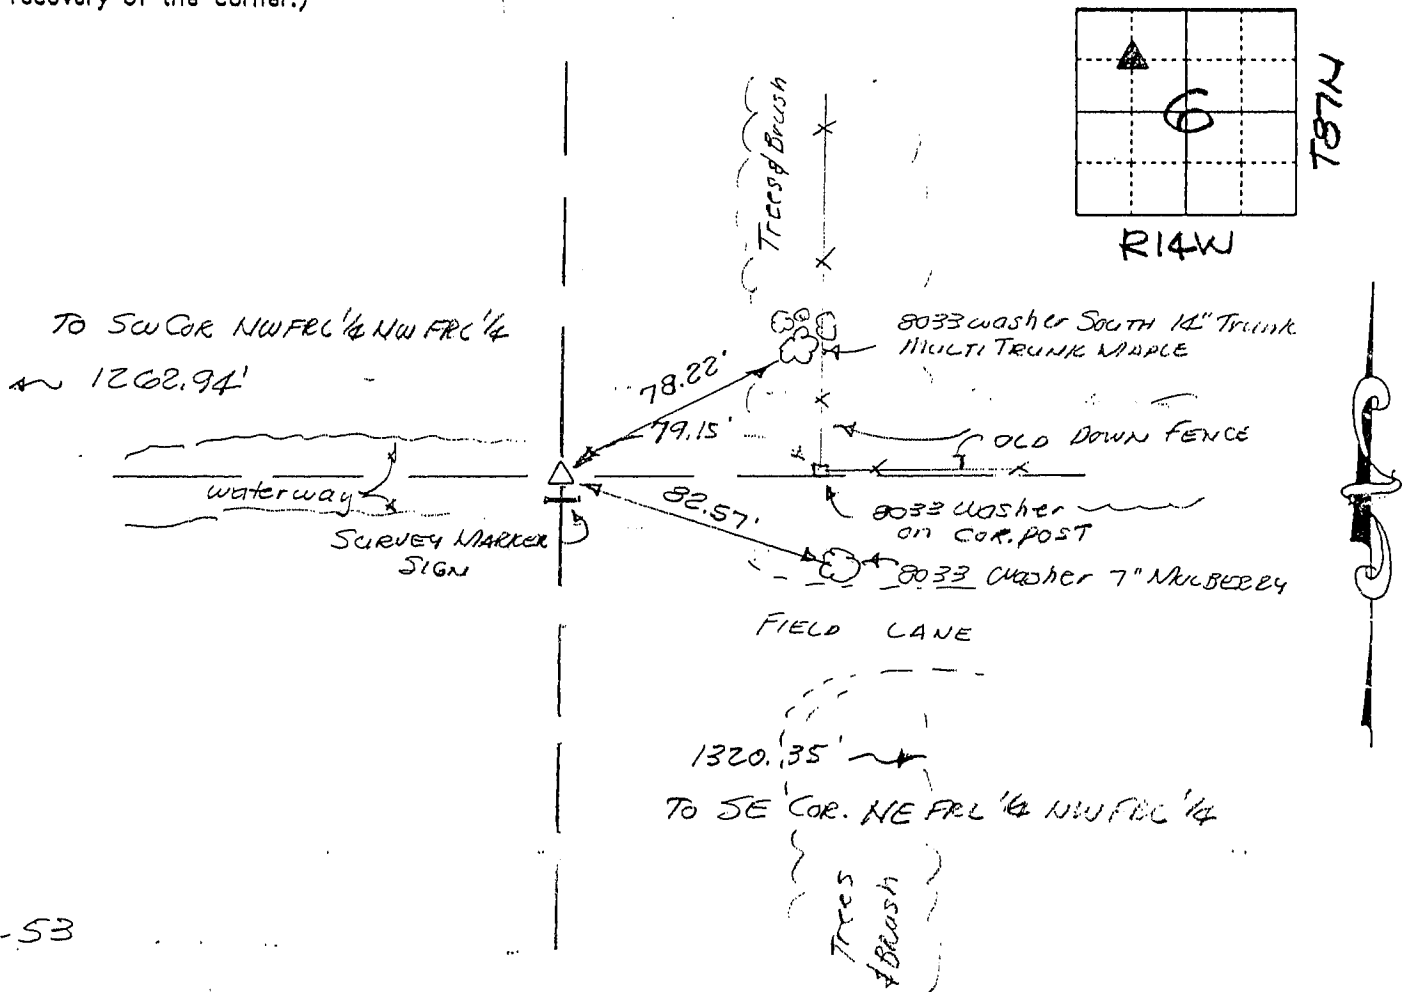


I hereby certify that the survey work was completed and this certificate was prepared by me or under my direct personal supervision and that I am a duly licensed land surveyor under the laws of the state of Iowa.

Signature: F. William King
(Name typed or printed:) F. WILLIAM KING

Date: JULY 14, 2000 Lic. No. 8033

SEAL

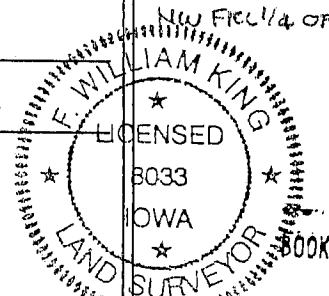

List Corners to be Indexed

Corners	Section	Twp	Range
SW COR. OF NE FRL 1/4 OF NW FRL 1/4 OF	6	87N	14W