

001306

BLACK HAWK COUNTY IOWA:SS

Filed for record JUL 20, 2000 at
1:00 P.M. and recorded in Book

of Page

INDEX
MARGIN
PROOF
COMPARE

FEE 1-5.00/

WAYNE CLAASSEN ENGINEERING AND SURVEYING INC

WAYNE CLAASSEN ENGINEERING AND SURVEYING, INC.
P.O. BOX 898 WATERLOO, IOWA 50704-0898PHONE: (VOICE) 319-235-6294
(FAX) 319-235-0028

UNITED STATES PUBLIC LAND SURVEY CORNER CERTIFICATE


and Survey Monuments situated in Section 6, Township 87N, Range R14W, of the Fifth Principal Meridian, BLACK HAWK County, Iowa.Previously recorded in N/A in County Recorder's Office.
(book, page, document number, etc.)

Show reason for preparing this certificate, the evidence and detailed procedures used in establishing the corner positions and monumentation found or placed.)

Monument Description and Remarks Found 5/8" rebar 5" deep in gravel road. This rebar was set in 1977 by F.W. King using Grundy Co. Engineer's ref. ties. 1977 ties were furnished to BH Co. Engr. Dept. (W 1/4 Cor. 6-87-14)

PLAN - VIEW

Show a minimum of three reference ties to durable physical objects, relevant monuments and physical conditions that will enable recovery of the corner.)

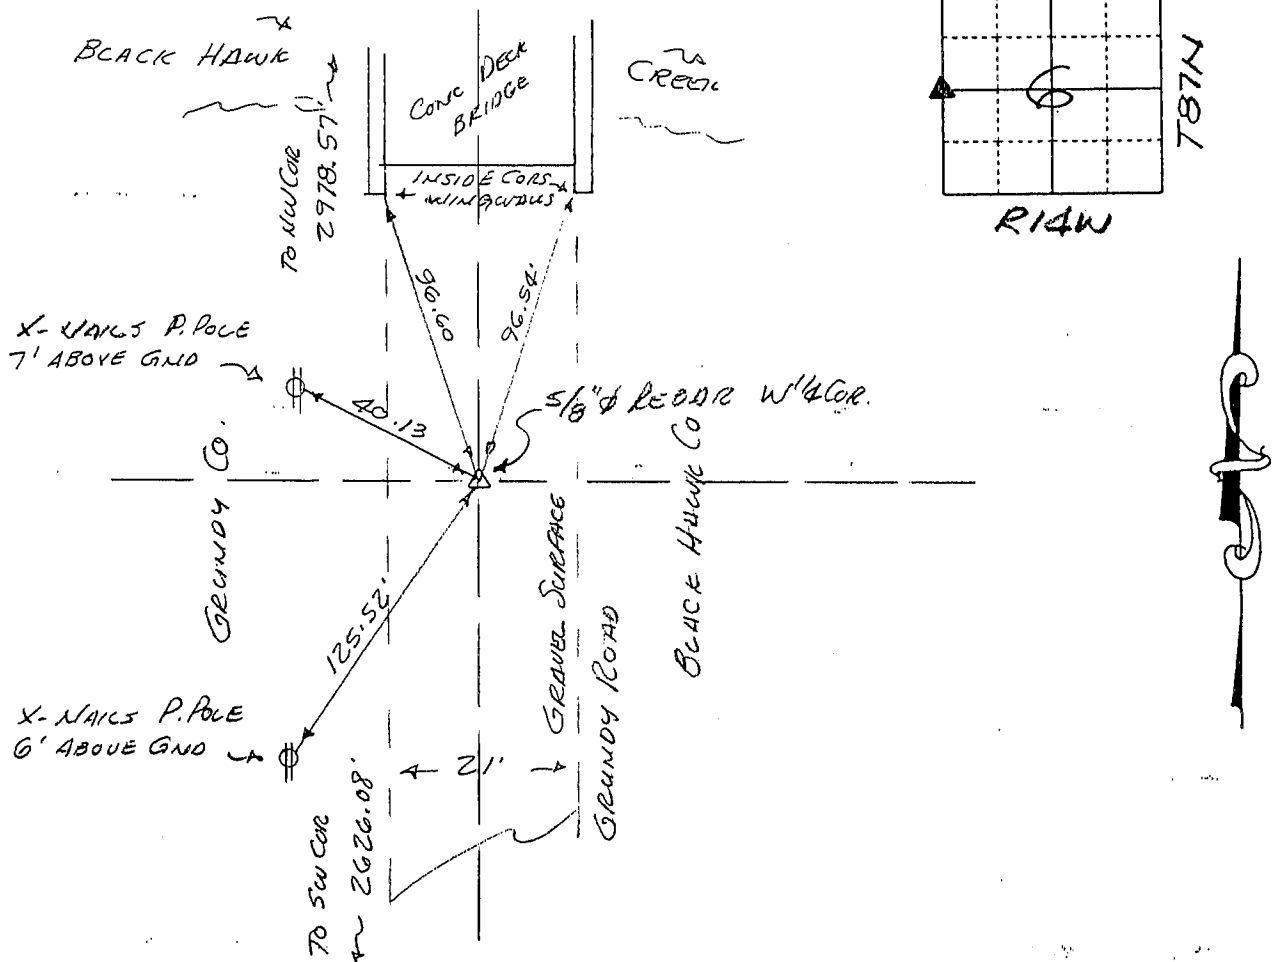

484-51


I hereby certify that the survey work was completed and this certificate was prepared by me or under my direct personal supervision and that I am a duly licensed land surveyor under the laws of the state of Iowa.

Signature: F. William King
(Name typed or printed:) F. William King
Date: June 30, 2000 Lic. No. 8033

SEAL

List Corners to be Indexed

Corners	Section	Twp	Range
W 1/4 Cor	6	87N	14W

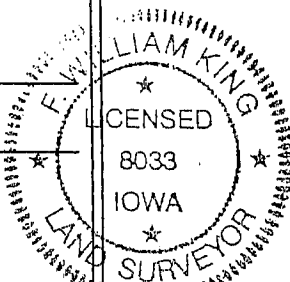

BOOK 339 PAGE 368