2024-14918

RECORDED: 05/29/2024 02:35:29 PM

RECORDING FEE: \$7.00 IOWA E-FILING FEE: \$3.00 COMBINED FEE: \$10.00 REVENUE TAX: \$0.00

SANDIE L. SMITH, RECORDER BLACK HAWK COUNTY, IOWA

Prepared by & Return to: Christopher C. Sweeney, HRS, LLC, 2206 East Bremer Avenue, Waverly, IA 50677, Phone 319-483-5187

## **United States Public Land Survey Corner Certificate**

Land Survey Monument situated in

Section 7, Township 87 North, Range 14 West of the Fifth Principal Meridian, Black Hawk County, Iowa.

On file in Document #2011-00018199 in the County Recorder's Office.

This certificate is being prepared in compliance with Iowa Code Chapter 355.11 because:

□ There is no certificate on file for this corner.
 ☑ There are no longer three valid ties of record.
 □ There are changes to reference ties of record.
 □ There is change of monumentation of record.
 □ To clarify description of record monument (ties).


## **Monument Description and Remarks:**

## East 1/4 Corner:

Found Concrete Monument (8" Deep) with information obtained from the previously recorded Section Corner Certificate.

## **Plan View - Not to Scale**

(Show a minimum of three reference ties to durable physical objects, relevant monuments and physical conditions that will enable recovery of the corner.)

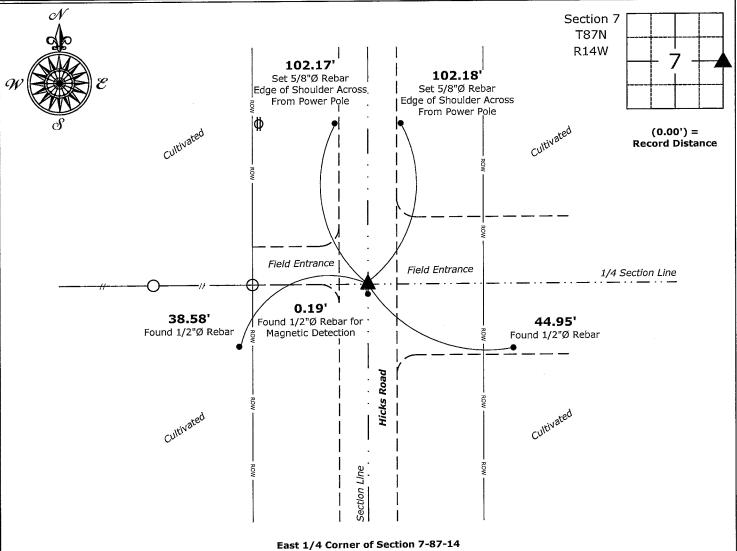

CHRISTOPHER 22
CC. SWEENEY

I hereby certify that this land surveying document was prepared and the related survey work was performed by me or under my direct personal supervision and that I am a duly licensed Land Surveyor under the laws of the State of Iowa.

Christopher C. Sweeney

5-24-2024 Date:

Found Concrete Monument (8" Deep)

License number 27466 My license renewal date is December 31, 2025 Sheets covered by this seal: Individual sheet only List Corner to be Indexed

Corner Section Township Range

E 1/4 7 87 14

Project Number: 2024-542 FB: Black Hawk 12, Page(s) 14-16 File: I:\\_\_Projects - WO\County Control Systems\\_WO\BLACK HAWK\BHCO-26\BHCO-26-2024.dwg, 5/24/2024 9:55:11 PM