

SC ✓
Misc ✓
INDEXED
MARGIN
PROOF
COMPARE

BLACK HAWK COUNTY IOWA: SS 14637
Filed for record Feb 6, 19 97 at
3:00 P.M. and recorded in Book 323
of Misc Page 921.
Patricia A. Sess Recorder
Fee 1-5.00x

PAUL H. HELLAND, 2322 W. 1ST ST., SUITE B, CEDAR FALLS, IOWA 50613, (319)-266-0161

UNITED STATES PUBLIC LAND SURVEY CORNER CERTIFICATE OF



Land Survey Monuments situated in Section 7, Township 87, Range 14, of the Fifth Principal Meridian, BLACK HAWK County, Iowa.
Previously recorded in Book _____, Page _____.

(Show reason for preparing this certificate, the evidence and detailed procedures used in establishing the corner positions and monumentation found or placed.)

Monument Description and Remarks: SURVEY DONE IN SE 1/4 SEC. 6-87-14.
NE CORNER - FOUND CONCRETE MONUMENT W/BRASS CAP 0.9' DEEP
N 1/4 CORNER - COUNTY TIES OBLITERATED, DUG IN LINE W/FENCE
NORTH & 35.5' SOUTH OF NORTH R.O.W. FENCE, NO CORNER FOUND
SET NO. 4 REBAR W/CAP #6505

PLAN - VIEW

(Show a minimum of three reference ties to durable physical objects, relevant monuments and physical conditions that will enable recovery of the corner.)

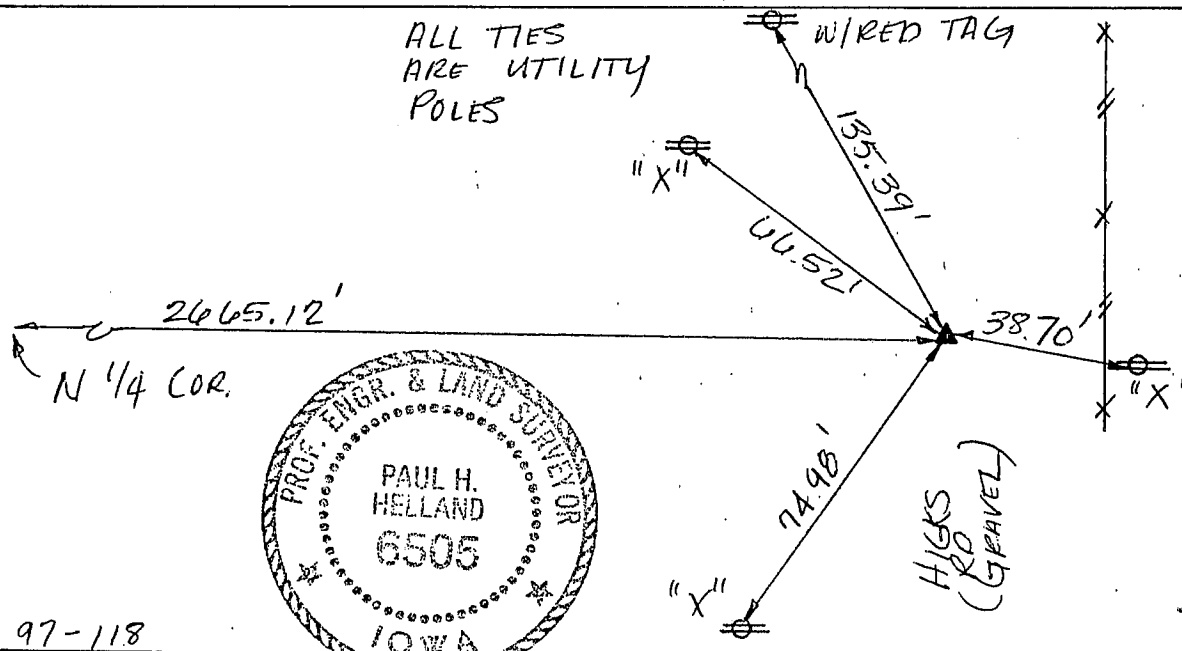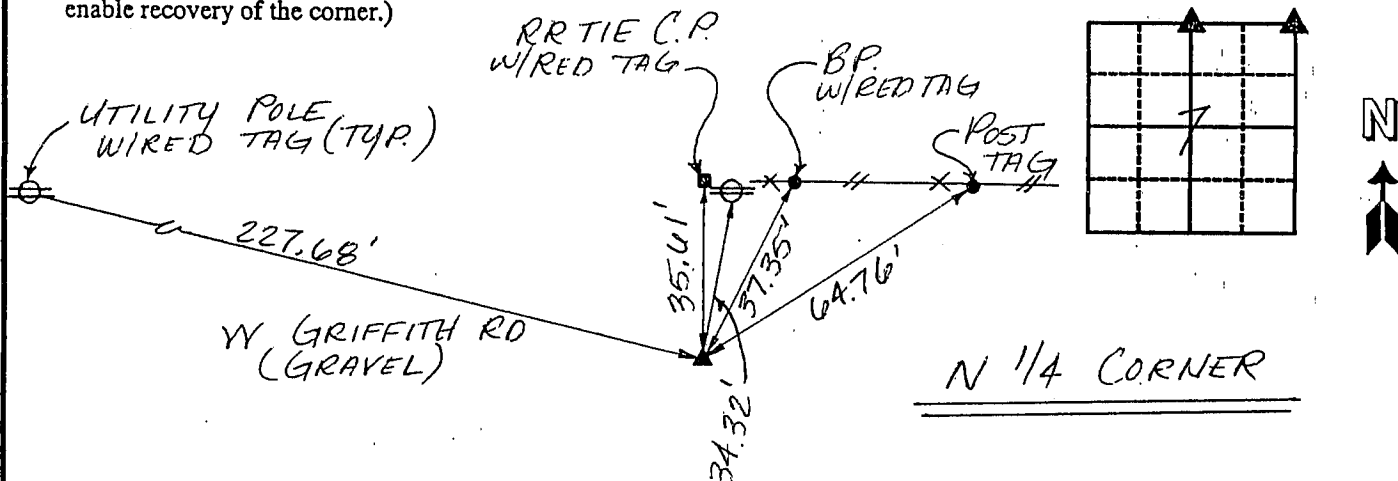

List Corners to be Indexed

Corners	Section	Twp	Range
NE	7	87	14
N 1/4	7	87	14

BOOK 323 PAGE 921

I HEREBY CERTIFY THAT THIS PLAT, MAP, SURVEY OR REPORT WAS MADE BY ME OR UNDER MY DIRECT PERSONAL SUPERVISION AND THAT I AM A DULY REGISTERED LAND SURVEYOR UNDER THE LAWS OF THE STATE OF IOWA.
Paul H. Helland DATE 2/6/97
PAUL H. HELLAND, P.E. & R.L.S. IOWA REGISTRATION NO. 6505
MY REGISTRATION EXPIRES DECEMBER 31, 1997

HES

THUNDER RIDGE BANK BUILDING
2322 WEST 1ST ST., SUITE B
CEDAR FALLS, IOWA 50613
319-266-0161

HELLAND ENGINEERING & SURVEYING, LTD.