HELLAND ENGINEERING & SURVEYING LTD

Document Number: 2007020401

Date: Mar 30, 2007 4:30:00 pm

Aud Fee: Trans Tax:

0.00

Rec Fee: 5.00 Rec Management Fee:

1.00

0.00 1.00

Non-Standard Page Fee:

0.00

7

Filed for record in Black Hawk County, Iowa Judith A. McCarthy, County Recorder

Paul H. Helland, 1107 Technology Parkway, Cedar Falls, Iowa 50613-6951, (319)-266-0161

UNITED STATES PUBLIC LAND SURVEY CORNER CERTIFICATE OF

LAND SURVEY MONUMENTS SITUATED IN SECTION NO. 8__, TOWNSHIP NO. 87_NORTH, RANGE __WEST OF THE FIFTH PRINCIPAL MERIDIAN, **BLACK HAWK** COUNTY, IOWA.

PREVIOUSLY RECORDED IN


(SHOW REASON FOR PREPARING THIS CERTIFICATE, THE EVIDENCE AND DETAILED PROCEDURES USED IN ESTABLISHING THE CORNER POSITIONS AND MONUMENTATION FOUND OR PLACED.)

MONUMENT DESCRIPTION AND REMARKS:

NO USPLSCC ON FILE. SURVEY COMPLETED IN THE SE 1/4 OF SEC. 8-T87N-R14W.

S 1/4 CORNER: W.P.A. CHAINING NOTES DATED 9/16/1938 CALL FOR [SET C.M. 12" ON TOP UNDERGROUND].
ALL REFERENCE TIES HAVE BEEN OBLITERATED. FOUND NO. 4 REBAR 0.2' DEEP. REMOVED REBAR, PROBED AND HIT CM IN REBAR'S HOLE. REPLACED REBAR IN ORIGINAL POSITION AND UTILIZED AS CORNER. E 1/4 CORNER: BLACK HAWK COUNTY ENGINEER REFERENCE TIES CALL FOR [CM]. W.P.A. CHAINING NOTES

DATED 9/16/1938 CALL FOR [SET C.M. 12" ON TOP UNDERGROUND]. FOUND STANDARD CONCRETE MONUMENT W/BRASS CAP 0.6' DEEP. ALSO FOUND A 2" Ø OPEN PIPE 0.27' SWLY OF SAID CM. UTILIZED SAID C.M.

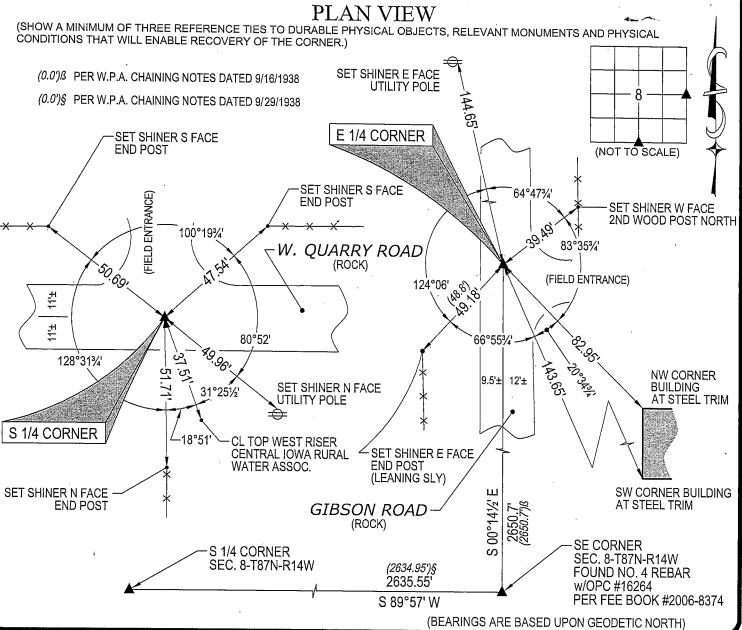

HELLAND ENGINEERING & SURVEYING, LTD. SHINER = 8D NAIL & 1 15/16"Ø METAL SHINER OPC = PLASTIC CAP (O=ORANGE, R=RED, Y=YELLOW)

I hereby certify that this land surveying document was prepared and the related survey work was performed by me or under my direct personal supervision and that I am a duly licensed Land Surveyor under the laws of the State of lowa.

Paul H. Helland License Number 6505 Wille My license renewal date is December 31, 2007.
All pages or sheets are covered by this seal except:

LIST CORNERS TO BE INDEXED CORNER SECTION TOWNSHIP **RANGE** S 1/4 CORNER 14W 87N E 1/4 CORNER 87N 14W

FILE NAME: 07-130C1.DWG

(00') RECORDED AS

Rec



1107 Technology Parkway Cedar Falls, Iowa 50613-6951 (319)-266-0161