



PREPARED BY
AND RETURN THIS ORIGINAL DOCUMENT TO:
JON MYERS PLS
IOWA DEPARTMENT OF TRANSPORTATION
DISTRICT 1 OFFICE
1020 SOUTH 4TH STREET
AMES, IOWA 50010
PHONE 515-239-1593

RESERVED FOR COUNTY RECORDER'S USE

2024-15104
RECORDED: 05/31/2024 03:49:59 PM
RECORDING FEE: \$7.00
IOWA E-FILING FEE: \$3.00
COMBINED FEE: \$10.00
REVENUE TAX: \$0.00
SANDIE L. SMITH, RECORDER
BLACK HAWK COUNTY, IOWA

UNITED STATES PUBLIC LAND SURVEY CORNER CERTIFICATE


Land Survey Monument(s) situated in Section 10, Township 87 North, Range 14 West, of the Fifth Principal Meridian, BLACKHAWK County, Iowa. IDOT Project NHSX-063-5(72)--3H-86
Previously recorded in FILE #2011-00008494 in the
County Recorder's Office.

E 1/4 CORNER 10-87-14:

A SURVEY OF THE US 63 HIGHWAY CORRIDOR WAS CONDUCTED BEFORE CONSTRUCTION OF PCC MAT. OVERLAY, FOR IOWA D.O.T. PROJECT: NHSX-063-5(72)--3H-86
A SURVEY MARK NAIL WITH STAINLESS STEEL WASHER WITH #19211 WAS FOUND BY A CORNER CERTIFICATE BY KIRK D. REICKS. ACCEPTED FOUND SURVEY MARK NAIL WITH WASHER AS THE SECTION CORNER MONUMENT FOR THE E 1/4 CORNER SEC. 10-87N-14W. POSITION OF SAID MONUMENT WAS PRESERVED BY PERFORMING REDUNDANT R.T.K. GPS OBSERVATIONS.

AFTER CONSTRUCTION, RE-SET CORNER WITH A 1" x 3" LONG STEEL SURVEY MARK NAIL SET INSIDE OF A CUT "X" IN CONCRETE ROAD AT THE LOCATION OF FOUND CONCRETE MONUMENT.


CORNER CERTIFICATE CREATED BECAUSE THE CORNER MONUMENT HAS CHANGED.

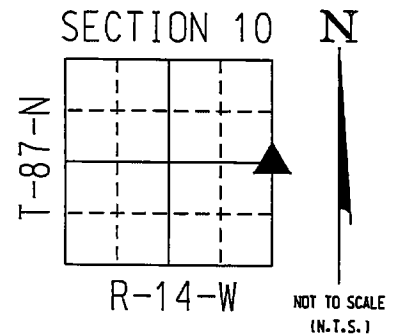


COORDINATE VALUE WAS ESTABLISHED UTILIZING NAD83 (2011)(EPOCH 2010) DATUM USING THE IOWA REGIONAL COORDINATE SYSTEM ZONE 5 PROJECTION IN U.S. SURVEY FEET

E 1/4 CORNER - #8023
N - 8795341.9420
E - 15444279.4300

PLAN - VIEW

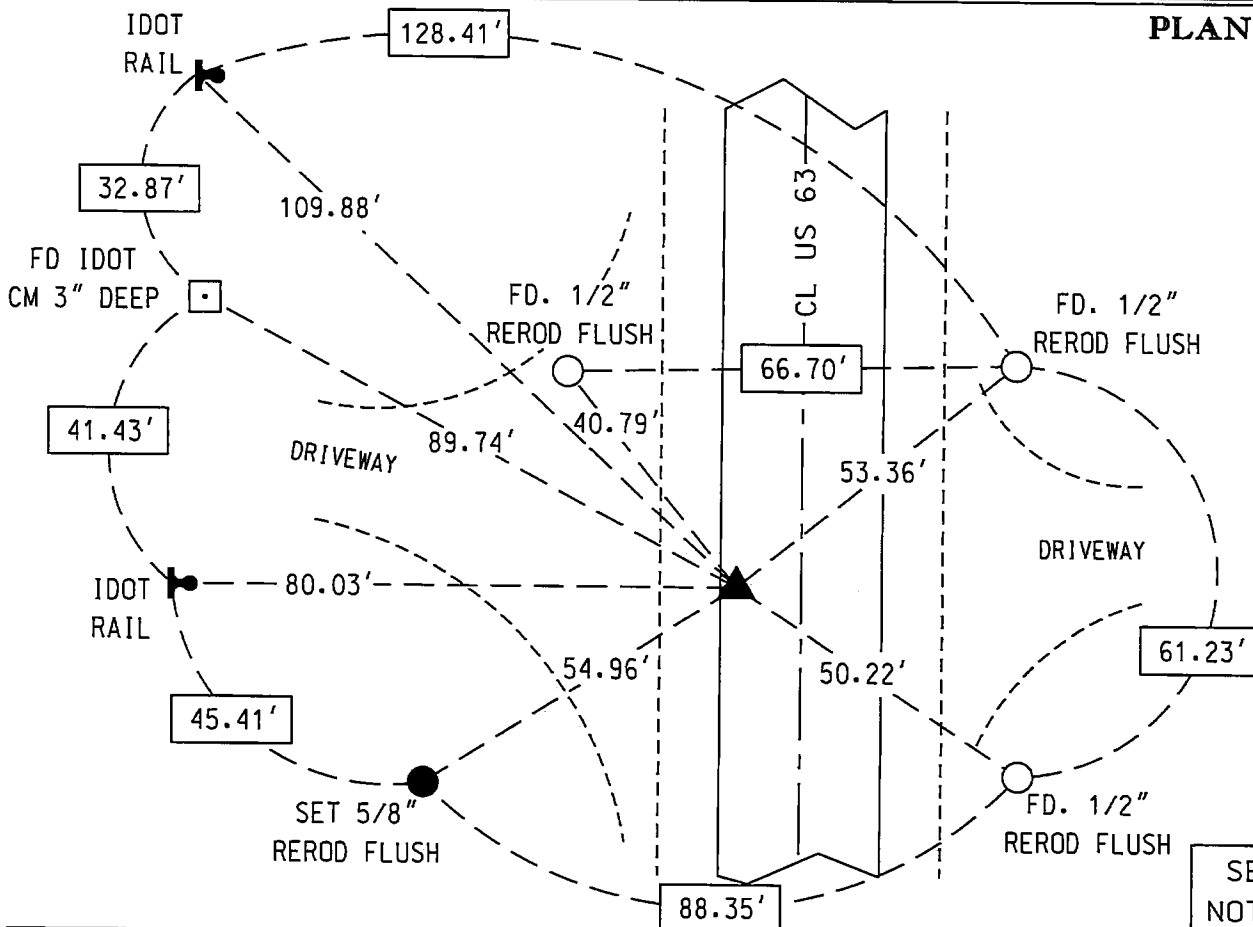

SEC COR IS NOT "X" TIED

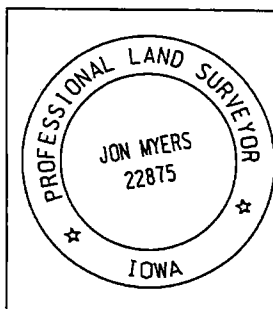

I hereby certify that this Land Surveying document was prepared by me or under my direct personal supervision and that I am a duly licensed Professional Land Surveyor under the laws of the State of Iowa.

Signature: _____
Date: November 8, 2023 Lic. No. 22875
My license renewal date is December 31, 2024.
Pages or sheets covered by this seal. 1

- SM = SET SURVEY MARK TAB IN WOOD POST
- = SET 5/8" REROD
- = FND CONC. MON.
- ⌵ = FD IDOT RAIL
- = FD RE-ROD

Corner to be Indexed
E 1/4 COR

Sec.	Twp.	Range
10	87	14

Drawn by: BRW